

KANSAS


Ellis

Form 51-5M-7-39-Palace

Section 1 Township 11 Range 18-W

Well No. #2 Riddler "B"

Company Bay Petroleum

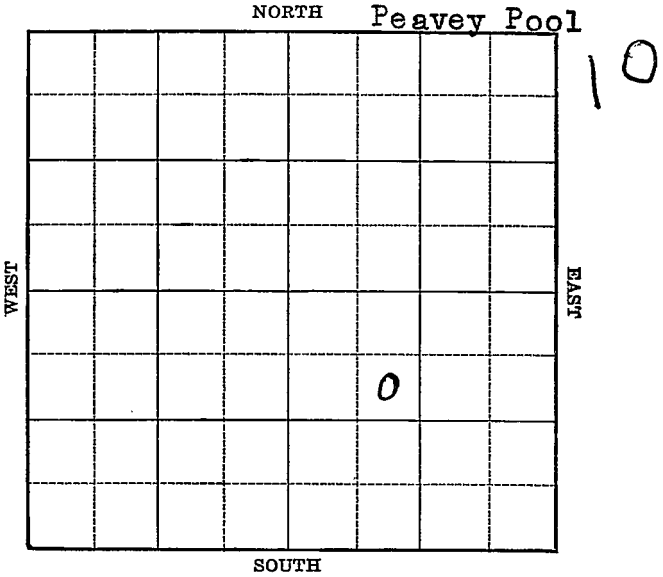

Sec. 1 Twp. 11 R. 18-W

Well No. #2 Riddler "B" Farm

Bay Petr. Company

(Peavey)


990 Ft. from N. Line

_____ Ft. from S. Line

_____ Ft. from E. Line

990 Ft. from W. Line

Elv. 1967

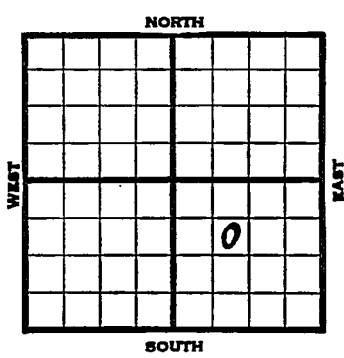

1939	REPORT
12/13	Rotary.
12/21	Surface hole.
12/28	" "
1940	
1/4	Anhy 1231' 10" - 1235'
	Drlg. 2804'
1/10	Lans. 3184' Arb. 3428 ³⁴⁹⁹ 3502'
1/17	T.D. 3499' Run 7".
1/18	Arb. 3502 ³⁴⁹⁹ (Corrected)
	7" - 3502 ³⁴⁹⁹ Drlg. 3506' 3502'
	3000' oil.
1/24	Arb. 3499' (Corrected)
	7" - 3499' "
	T.D. 3502'
	Echometer Potential 17,112 bbls.
	Maximum 3000 bbls.
	COMPLETED

Map No. 71 Sec. 1 Twp. 11 R. 18W

Well No. 2 Riddler "B"

Bay Petroleum Company

Contractor

FIRST REPORT

SE NW SE

990 Ft. from N. Line

_____ Ft. from S. Line

_____ Ft. from E. Line

990 Ft. from W. Line

SECTION PLAT

PEAVEY POOL

Location _____

Rig up _____

Drilling and Remarks:
Rotary

RECORD

Cased _____ in., _____ ft.

Sand _____

Gas _____

Oil _____

Total Depth _____

PRODUCTION

1st 24 hrs. Nat. _____

1st 24 hrs. after shot _____

Gas _____ Cu. Ft.

Dry Hole _____

Abandoned _____

Date _____

DEC 13 1939 19

S. J. LEWIS Scout

Ellis

KANSAS

Map No. 71 Sec. 1 Twp. 11 R. 18W

Well No. 2 Riddler "B"

Bay Petroleum Company

Contractor

COMPLETED
SE NW SE

SECTION PLAT

990 Ft. from N. Line

_____ Ft. from S. Line

_____ Ft. from E. Line

990 Ft. from W. Line

		o	

PEAVEY POOL

Location _____

Rig up _____

Drilling and Remarks:

*Core 3499. Corrected
7" C3499.*

*Electrometers P & J
17112.*

Maximum 3000

RECORD

Cased _____ in., _____ ft.

Sand _____

Gas _____

Oil _____

Total Depth 3502

PRODUCTION

1st 24 hrs. Nat. _____

1st 24 hrs. after shot _____

Gas _____ Cu. Ft.

Dry Hole _____

Abandoned _____

Date

JAN 24 1940 19

R. I. LEWIS Scout