

Sec. 1 Twp. 11 R. 18-W

Well No. #2 Burnett "E" Farm _____

Wakefield Company _____

(Burnett)


660 Ft. from N. Line

_____ Ft. from S. Line

990 Ft. from E. Line

_____ Ft. from W. Line

Elev. 1981

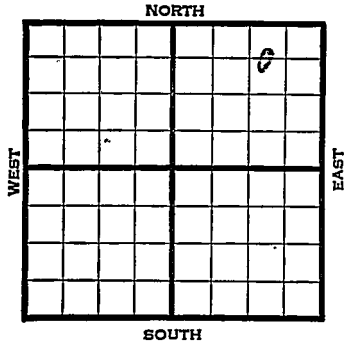

| 1940 | REPORT |
|-------|----------------------------------|
| 12/11 | 1200' run 8" |
| 12/19 | 8" - 1275' Drlg. 2264' |
| 12/26 | Drlg. 3085' |
| 1941 | |
| 1/2 | Cherty Cong. 3459' |
| | Simp. Dolo. 3508' |
| | Simp. sd. 3527' Arb. 3529-30' |
| | TD 3530' 5" - 3529' RUST. |
| 1/9 | T.D. 3532' 2800' oil 12 hours. |
| 1/15 | Arb. 3529' |
| | 5" - 3529' |
| | T.D. 3532' |
| | 1000 acid. |
| | Depthograph potential 1643 bbls. |
| | 36. Gravity |
| | COMPLETED |

Map No. 71 Sec. 1 Twp. 11 R. 18WWell No. 2 Burnett "E"Wakefield

Company

Contractor

FIRST REPORT

C W L NE NE

660 Ft. from N. Line Ft. from S. Line990 Ft. from E. Line Ft. from W. Line

BURNETT POOL

SECTION PLAT

| | | | |
|--|--|--|---|
| | | | o |
| | | | |
| | | | |
| | | | |

Location _____

Rig up _____

Drilling and Remarks:
1200' Run 8"**RECORD**

Cased _____ in., _____ ft.

Sand _____

Gas _____

Oil _____

Total Depth _____

PRODUCTION

1st 24 hrs. Nat. _____

1st 24 hrs. after shot _____

Gas _____ Cu. Ft.

Dry Hole _____

Abandoned _____

Date

DEC 11 1940 19____S. J. LEWIS Scout

Map No. 71 Sec. 1 Twp. 11 R. 18W

Well No. 2 Burnett "E"

Wakefield

Company

Contractor

COMPLETED

C W L NE NE

660 Ft. from N. Line

_____ Ft. from S. Line

990 Ft. from E. Line

_____ Ft. from W. Line

SECTION PLAT

| | | | |
|--|--|--|---|
| | | | o |
| | | | |
| | | | |
| | | | |

BURNETT POOL

Location _____

Rig up _____

Drilling and Remarks:

Cell 83529
5" C 35-29
10000 acid
Depth 81643
36° Gr.

RECORD

Cased _____ in., _____ ft.

Sand _____

Gas _____

Oil _____

Total Depth 3582

PRODUCTION

1st 24 hrs. Nat. _____

1st 24 hrs. after shot _____

Gas _____ Cu. Ft.

Dry Hole _____

Abandoned _____

Date

JAN 15 1949

S. J. LEWIS

Scout