

Ellis

KANSAS

1

11


18W

SECTION \_\_\_\_\_ TOWNSHIP \_\_\_\_\_ RANGE \_\_\_\_\_

WELL NO. #6 Burnett "Joint"

COMPANY E.F. Wakefield

NORTH <sup>N/2 N/2</sup>  
~~NE~~ NW NE

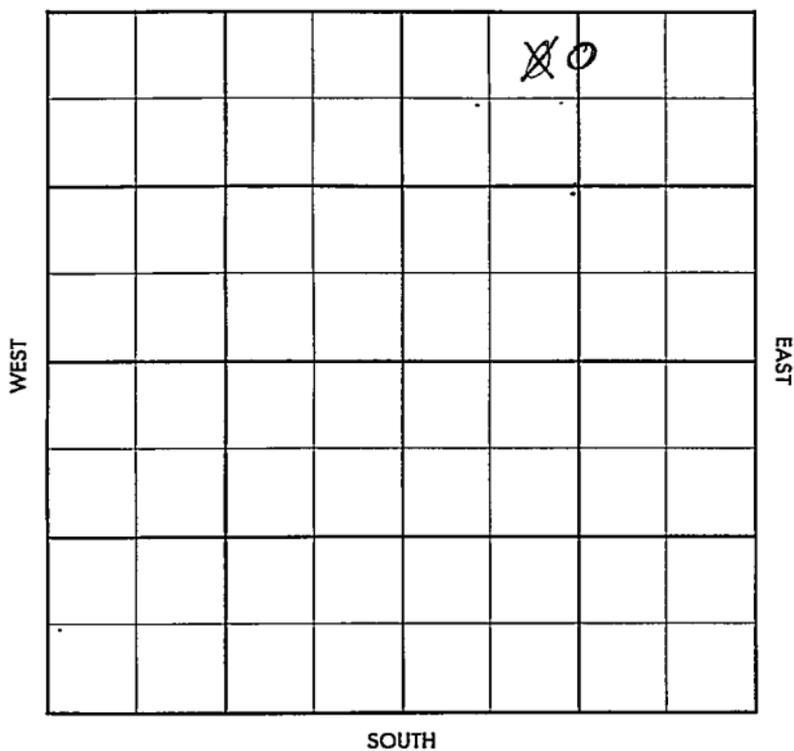

County ETWAS Elev. \_\_\_\_\_  
 Sec. 1 Twp. 11 Rgs. 1 NW  
 Company F. F. Wakefield  
 FarmName Burnett "Joint" No. 6

TOPS	DEPTH	LOG	DATUM	Loc. in Sec.
Anh.				<u>NE NW NE</u>
Tp.				
H.				
Tr.				
Dg.				
Bl.				
L.	<u>3190</u>			
K.C.				Geol. _____
B.K.C.				Contr. _____
Ce.				<u>Co. tools</u>
C.				Pool _____
M.				<u>Burnett</u>
M.				
K.				
Mz.				
Mo.				
V.				
S.				
S.				
A.				
R.				
Pe.				
G.				
T.D.				

FIRST REPORT  
 FEB 13 '57

Date Comm. 2-6-57  
8" @ 310/200 drlg. 3305

6

Co.

Lse.

T

No.

Sec.

T.

R.

# CORRECTION

FORM 513 SUNRAY

County	Ellis	Elev.	1998
Sec.	1	Twp.	11
		Rgs.	18W
Company	E. F. Wakefield		
Farm Name	Barnett "Joint"		No. 6

TOPS	DEPTH	LOG	DATUM	Loc. in Sec.
Anh.				<div style="border: 1px solid black; border-radius: 50%; padding: 5px; display: inline-block;">                     NE NE NE                      N2 N2                 </div>
Top	2985			
H.				
Tr.				
Dg.	3173			
BL.				
L.	3199			
K.C.				Geol.
B.K.C.				Contr.
Ce.				
C.	3472			Co. tools
M.				
M.				Pool
K.				Barnett
Mz.				
Mo.				
V.				
S.	3512			
S.				
A.	3541			APR 24 '57
R.				<div style="border: 1px solid black; padding: 5px; display: inline-block;"> <b>COMPLETE</b> </div>
PE.				
G.				
TD.	3630			

Date Comm. 2-6-57  
 8H @ 310/200 drlg. 3305

5 1/2 @ 3630 / W OCT  
 CO PF 3544-7A FU 2000' oil  
 no/w Pop MAR 1 '57 MAR 21 '57 WA 27.5'  
 APR 57 APR 10 '57 APR 17 '57 APR 24 '57 P. 25

Bopd no/w to