

# KANSAS

Form 51-5M-7-40-Palace


Ellis

Section 1 Township 11 Range 18-W

Well No. #2 Riddler

Company Wentz

NORTH Koblitz Pool

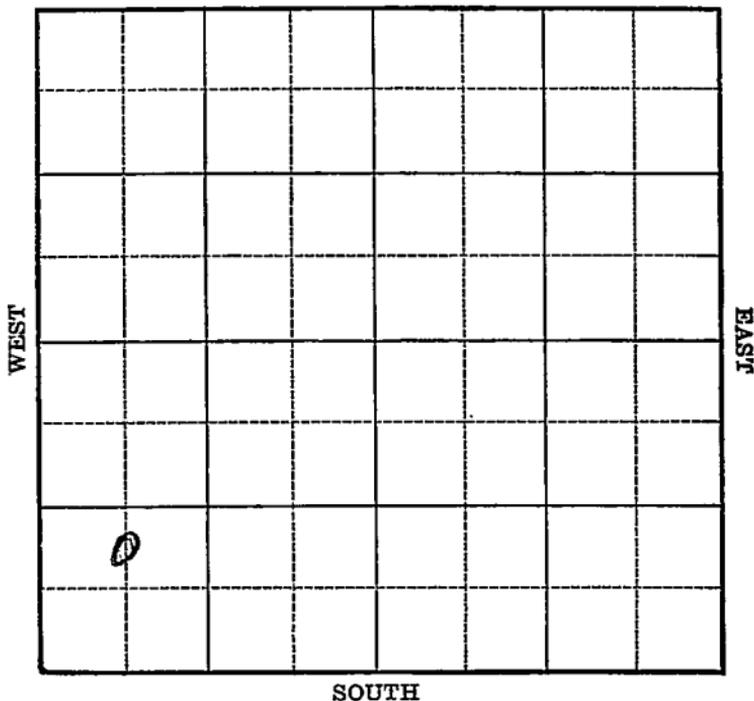

Sec. 1 Twp. 11 R. 18-W

Well No. #2 Riddler Farm

Wentz Company

(Koblitz)


\_\_\_\_\_ Ft. from N. Line

990 Ft. from S. Line

\_\_\_\_\_ Ft. from E. Line

660 Ft. from W. Line

Elev. 1980

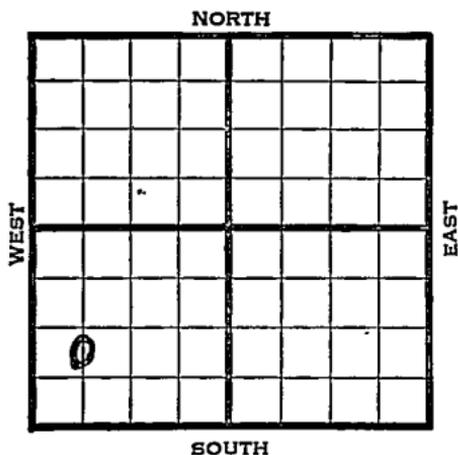

1940	REPORT
10/2	Location
10/10	Derrick.
10/17	" "
10/24	8" - 1293' Drlg. 3452'
10/31	Arb. 3525' 4" - 3525'
	T.D. 3529' RUST.
11/7	1000 acid. Swab 8½ bbls. per hr
11/14	" " "
11/21	" " "
11/26	Arb. 3525'
	4" - 3525'
	T.D. 3529'
	1000 acid.
	Potential 173 bbls., Swab.
	34.4 Gravity.
	COMPLETED

Map No. 7/ Sec. 1 Twp. 11 R. 18WWell No. 2 RiddlerWentz

Company

Contractor

## FIRST REPORT

C N L SW SW

         Ft. from N. Line990 Ft. from S. Line         Ft. from E. Line660 Ft. from W. Line

KOBELITZ POOL

## SECTION PLAT

o			

Location XRig up         

Drilling and Remarks:

## RECORD

Cased          in.,          ft.Sand         Gas         Oil         Total Depth         

## PRODUCTION

1st 24 hrs. Nat.         1st 24 hrs. after shot         Gas          Cu. Ft.Dry Hole         Abandoned         

Date

OCT 2 1940<sub>19</sub>S. J. LEWIS Scout

Map No. 71 Sec. 1 Twp. 11 R. 18W

Well No. 2 Riddler

Wentz Company

Contractor

**COMPLETED**

C N L SW SW

         Ft. from N. Line

990 Ft. from S. Line

         Ft. from E. Line

660 Ft. from W. Line

**SECTION PLAT**

o			

KOBLITZ POOL

Location                                 

Rig up                                 

Drilling and Remarks:

*Per 3525.  
4" C 3525.  
1000 acid  
swt. 173 P.Y.*

*34.4 Gr.*

**RECORD**

Cased          in.,          ft.

Sand                                 

Gas                                 

Oil                                 

Total Depth 3529

**PRODUCTION**

1st 24 hrs. Nat.                         

1st 24 hrs. after shot                         

Gas                                  Cu. Ft.

Dry Hole                                 

Abandoned                                 

Date

NOV 26 1940<sub>19</sub>

S. J. LEWIS Scout