

KANSAS

Ellis


Form 51-5M-7-39-Palace

Section 1 Township 11 Range 18-W

Well No. #4 Ridler "B"

Company Bay Petroleum

NORTH Burnett Pool

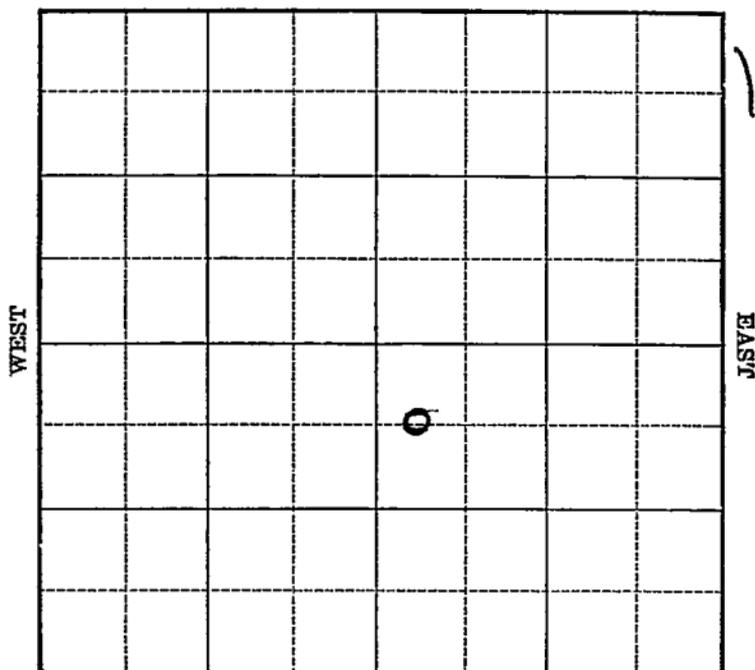

SOUTH

Map No. 71 Sec. 1 Twp. 11 R. 18W

Well No. 4 Ridler "B"

Bay Petroleum Company

Contractor

FIRST REPORT

C W L NW SE

660 Ft. from N. Line

_____ Ft. from S. Line

_____ Ft. from E. Line

330 Ft. from W. Line

SECTION PLAT

		o	

BURNETT POOL

Location _____

Rig up _____

Drilling and Remarks:

12" - 80'

WOC

RECORD

Cased _____ in., _____ ft.

Sand _____

Gas _____

Oil _____

Total Depth _____

PRODUCTION

1st 24 hrs. Nat. _____

1st 24 hrs. after shot _____

Gas _____ Cu. Ft.

Dry Hole _____

Abandoned _____

Date

JUN 12 1940 19

S. J. LEWIS Scout

Map No. _____ Sec. 1 Twp. 11 R. 18WWell No. 4 Ridler "B"

_____ Bay Petroleum _____ Company

_____ Contractor

COMPLETED**SECTION PLAT**

C W L NW SE

660 Ft. from N. Line

_____ Ft. from S. Line

_____ Ft. from E. Line

330 Ft. from W. Line

		0	

BURNETT POOL

Location _____

Rig up _____

Drilling and Remarks:

*Cr 83469**5" @ 3470**3000 acid**Echometer 5695**May 3000***RECORD**

Cased _____ in., _____ ft.

Sand _____

Gas _____

Oil _____

Total Depth 3477**PRODUCTION**

1st 24 hrs. Nat. _____

1st 24 hrs. after shot _____

Gas _____ Cu. Ft.

Dry Hole _____

Abandoned _____

Date

JUL 10 1940 19S. J. LEWIS Scout