

# KANSAS

Ellis


Form 51-5M-7-39-Palace

Section 1 Township 11 Range 18-W

Well No. #2 Ridler

Company Tidewater

NORTH Burnett Pool

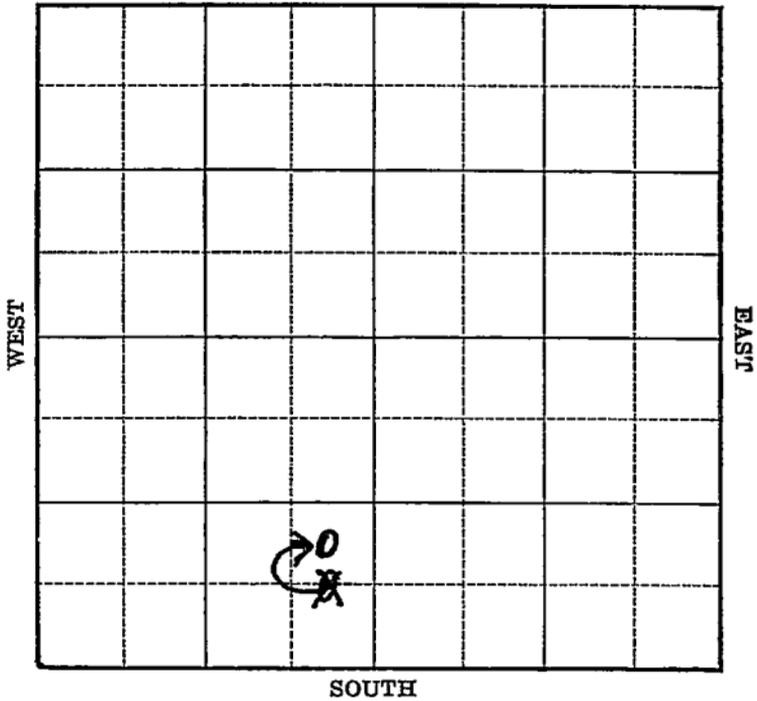

Sec. 1 Twp. 11 R. 18-W

Well No. #2 Ridler Farm

Tidewater Company

Company

(Burnett)

           Ft. from N. Line

990


660 Ft. from S. Line

330

Ft. from E. Line

           Ft. from W. Line

Elev. 1892

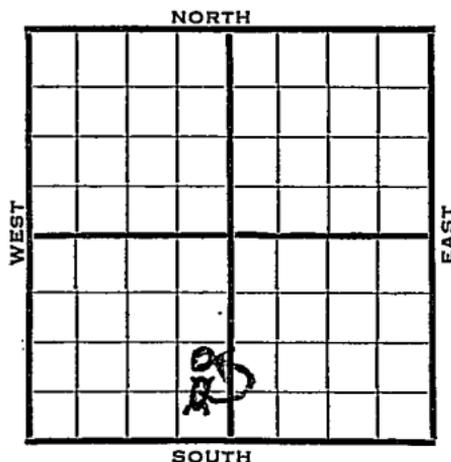

1940	REPORT
5/29	Derrick.
6/6	13" - 58' Anhy 1153'
	8" - 1167' Drlg. 1624'
6/13	Drlg. 2941'
6/20	Lans. 3113' Arb. 3422'
	5" - 3422½' T.D. 3426½' RUST.
6/26	Arb. 3422'
	5" - 3422½'
	T.D. 3428'
	500 acid.
	Depthograph potential 17,975 bbls.
	Maximum 3000 bbls.
	<b>COMPLETED</b>

Map No. 71 Sec. 1 Twp. 11 R. 18W

Well No. 2 Ridler

Tidewater Company

Contractor

**FIRST REPORT**

C E L S E S W

\_\_\_\_\_ Ft. from N. Line

660 Ft. from S. Line

330 Ft. from E. Line

\_\_\_\_\_ Ft. from W. Line

BURNETT POOL

**SECTION PLAT**


Location \_\_\_\_\_

Rig up \_\_\_\_\_

Drilling and Remarks:

Derrick

**RECORD**

Cased \_\_\_\_\_ in., \_\_\_\_\_ ft.

Sand \_\_\_\_\_

Gas \_\_\_\_\_

Oil \_\_\_\_\_

Total Depth \_\_\_\_\_

**PRODUCTION**

1st 24 hrs. Nat. \_\_\_\_\_

1st 24 hrs. after shot \_\_\_\_\_

Gas \_\_\_\_\_ Cu. Ft.

Dry Hole \_\_\_\_\_

Abandoned \_\_\_\_\_

Date

MAY 29 1940 19

S. J. LEWIS Scout

Map No. 71 Sec. 1 Twp. 11 R. 18WWell No. 2 Ridler

Tidewater

Company

CORRECTION

Contractor

NE SE SW

\_\_\_\_\_ Ft. from N. Line

990 Ft. from S. Line330 Ft. from E. Line

\_\_\_\_\_ Ft. from W. Line

BURNETT POOL

## SECTION PLAT


Location \_\_\_\_\_

Rig up \_\_\_\_\_

Drilling and Remarks:

Reported

C E L SE SW

## RECORD

Cased \_\_\_\_\_ in., \_\_\_\_\_ ft.

Sand \_\_\_\_\_

Gas \_\_\_\_\_

Oil \_\_\_\_\_

Total Depth \_\_\_\_\_

## PRODUCTION

1st 24 hrs. Nat. \_\_\_\_\_

1st 24 hrs. after shot \_\_\_\_\_

Gas \_\_\_\_\_ Cu. Ft.

Dry Hole \_\_\_\_\_

Abandoned \_\_\_\_\_

Date

JUN 5 1940 19

S. J. LEWIS

Scout

