

A 10x10 grid map. The left edge is labeled 'WEST' and the right edge is labeled 'EAST'. The bottom edge is labeled 'SOUTH'. A small circle is drawn in the third column from the left and the third row from the bottom.

Sec. 1 Twp. 11 R. 18-W

Well No.: #2 Ridler Farm

Skelly Company

Burnett


 Ft. from N. Line

990 Ft. from S. Line

990 Ft. from E. Line

 Ft. from W. Line

NW S E NW

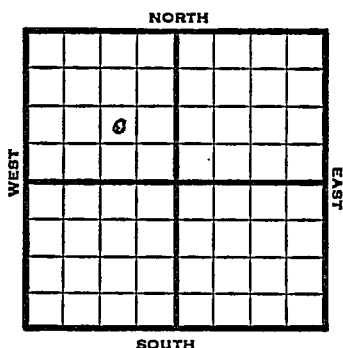

1948 Eli 1910' REPORT

11/3 Drlg 1100
11/10 "
11 16 Lansing 3137'
Simpson 3426'
Arbuckle 3440'
TD 3450'
5" @ 3441'
11/23 1000' oil 16 hrs.
TD 3452 '
11/30 "
12/8 300 acid fag swabb
12/15 PB 3446'
12/22 "
12/29 TD 3452 '
Arb. 3440
5"@ 3441
1400 acid
Pump 35 oil / 90% WPot
36° Gr.
Comp

COMPLETED

Map No. _____ Sec. 1 Twp. 11 R. 18W

Well No. 2 Ridler

Skelly Company

FIRST REPORT

Contractor

NW SE NW

SECTION PLAT

_____ Ft. from N. Line

990 Ft. from S. Line

990 Ft. from E. Line

_____ Ft. from W. Line

	0		

Ellis County

RECORD

Location _____

Rig up _____

Drilling and Remarks:

drlg. 1100

Cased _____ in., _____ ft.

Sand _____

Gas _____

Oil _____

Total Depth _____

PRODUCTION

1st 24 hrs. Nat. _____

1st 24 hrs. after shot _____

Gas _____ Cu. Ft.

Dry Hole _____

Abandoned _____

Date

NOV 3 1948 19

S. J. LEWIS

Scout

Map No. 71 Sec. 1 Twp. 11 R. 18W

Well No. 2 Ridler

Skelly Company

COMPLETE

Contractor

NW SE NW


E. 11910
SECTION PLAT

 Ft. from N. Line

990 Ft. from S. Line

990 Ft. from E. Line

 Ft. from W. Line

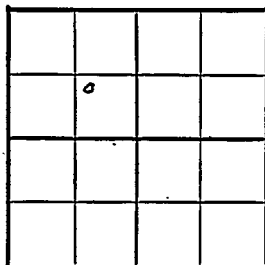

Ellis County

Location

Rig up

Drilling and Remarks:

As 83440

5" @ 8441

1400 @ 8456

Pump 35 oil + 90% water

36 2 1/2

RECORD

Cased in., ft.

Sand

Gas

Oil /

Total Depth 3452

PRODUCTION

1st 24 hrs. Nat.

1st 24 hrs. after shot

Gas Cu. Ft.

Dry Hole

Abandoned

Date

DEC 29 1948

19

S. J. LEWIS

Scout