


DX 78-1 Ellis

Section 1 Township 11 Range 20W

Well No. 1 Armbrister

Company Lewis Mai

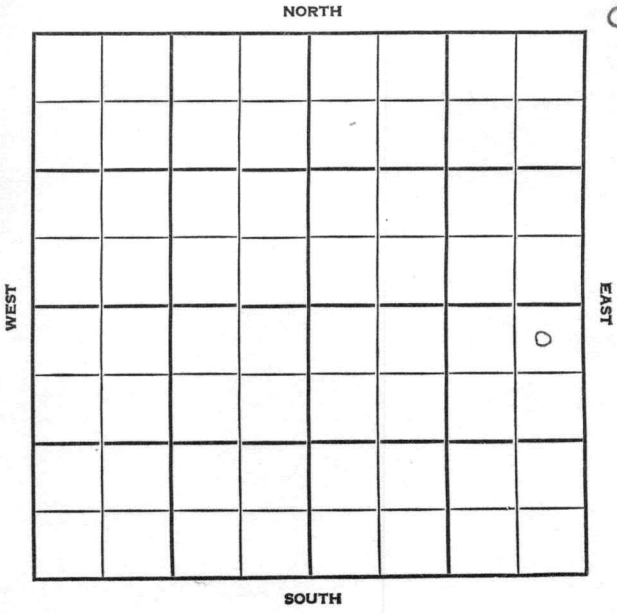

SEC. 1 TWP. 11 R. 20W

WELL NO. #1 Armbrister FARM

COMPANY Lewis Mai

CONTRACTOR Mast Drlg.

Warren Pool


330 FT. FROM N. LINE

FT. FROM S. LINE

330 FT. FROM E. LINE

FT. FROM W. LINE

NE NE SE

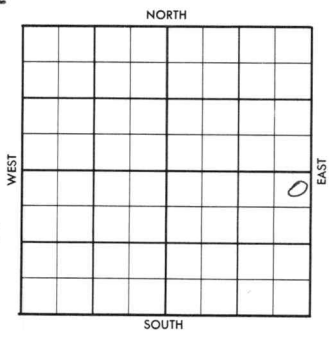

1956 ELEVATION REPORT

4-27 Spud 4-24-55
8" @ 225
WOC

County **Ellis** State **Kansas**

Sec. **1** (Blk.) **11** (Sur.) **20W** Map No.

Operator **Lewis Mai**

Well No. **1** Farm **Armbrister**

Elev. Location **NE NE SE**

330 Ft. From **N** Line **SE**
330 Ft. From **E** Line Quarter

Ist. Report **APR 27 1955**

Completion

Remarks

Mast Drlg. - Contr.

Spudding Date **4-24-55**

Drlg. Data **Warren Pool**

8" @ 225 WOC

FABEN GILSTRAP