


Section 1 Township 11 Range 20W

Well No. #1 Keller

Company Trans-Era Petr.

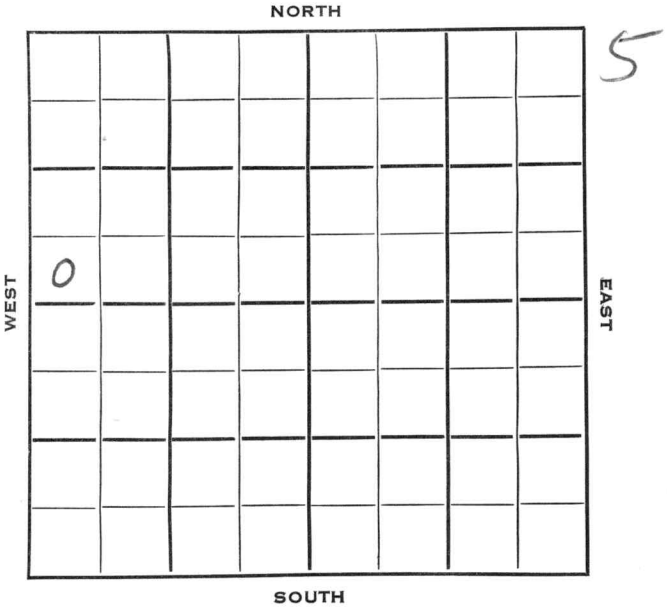

Sec. 1 Twp. 11 R. 20W

Well No. #1 Keller Farm

Trans-Era Pet. Company

Trans-Era Contractor

\_\_\_\_\_ Ft. from N. Line


330 Ft. from S. Line

\_\_\_\_\_ Ft. from E. Line

330 Ft. from W. Line

SW SW NW

Sinclair - support

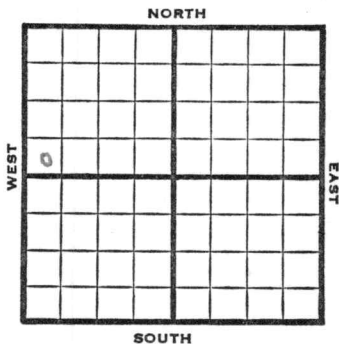

1953

Elev. 2124' REPORT

5/6

MIRT

5/20

Spud 5-7-53 D & A TD 3773'  
 8" @ 206 Top 3158 Heeb 3376  
 KC 3416 Cong. 3674' Arb. 3743  
 TD 3773' D & A

**ABANDONED**

County Ellis State Kansas

Sec. 1 (Blk. 11 (Sur. Rge.) 20W Map No.

Operator Trans-Era Pet.

Well No. 1 Farm Keller

Elev. \_\_\_\_\_ Location SW SW NW



330 Ft. From S Line NW

330 Ft. From W Line Quarter

1st. Report MAY 6 1953

Completion \_\_\_\_\_

Remarks Sinclair - support

Trans-Era - Contr.

Spudding Date \_\_\_\_\_

Drlg. Data \_\_\_\_\_

**MIRT**

County Ellis State KansasSec. 1 (Blk.  
Twp.) 11 (Sur.  
Rge.) 20W Map No.Operator Trans-Era Pet.Well No. 1 Farm KellerElev. 2124 Location SW SW NW330 Ft. From S Line NW330 Ft. From W Line Quarter

1st. Report

Completion MAY 20 1953

Remarks

Trans-Era - Contr.Spudding Date 5-7-53Drlg. Data D & A TD 37738" @ 206 Top. 3158 Heeb. 3376KC 3416 Cong. 3674 Arb. 3743 TD 3773D & A