


DX 78-1 **Ellis**

KANSAS

Section 1 Township 11S Range 20W

Well No. #1 Armbrister

Company Petroleum Management (Stableford)

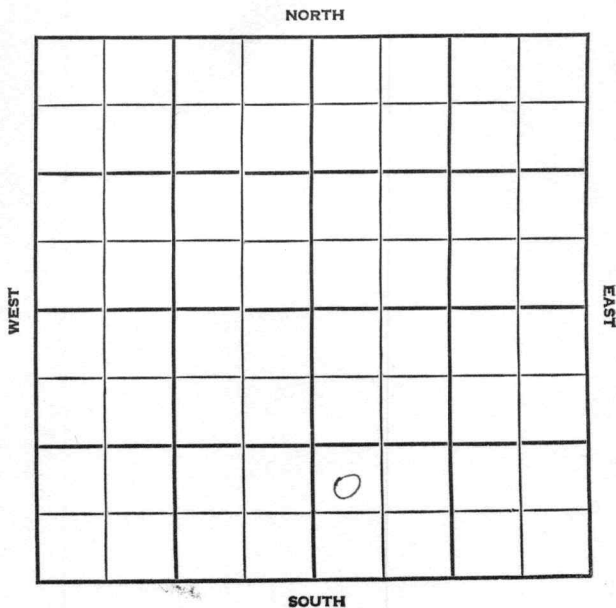

Ellis

KANSAS

SEC. 1	TWP. 11	R. 20W
-----------	------------	-----------

WELL NO.

#1 Armbrister

FARM

COMPANY

Petroleum Management (Stableford)

CONTRACTOR

Sierra

Warren


_____ FT. FROM N. LINE

_____ FT. FROM S. LINE

_____ FT. FROM E. LINE

_____ FT. FROM W. LINE

NW SW SE

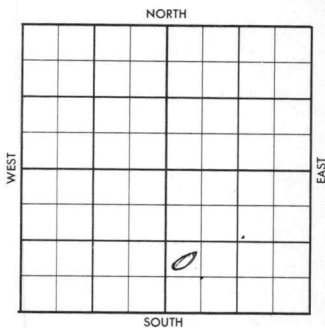

1956	ELEVATION 2142'	REPORT
------	--------------------	--------

- 8-1 Comm. 7-26-56
8" @ 204 w/125
Drlg. 2635
- 8-15 DST 3433-57 op 1 hr. rec. 40' SOCM,
BHP 130/20"
DST 3457-96 op 90 min. rec. 307'
MSOCSW; BHP 740/30".
DST 3580-3624 op 90 min. rec. 200' MSW
BHP 955/20".
DST 3658-95 op 45 min. rec. 10' mud,
BHP 70/20".
DST 3732-42 op 1 hr., rec. 1680' SW,
1130/20".
D & A
H. 3375'; L. 3411'; C. 3669'; A. 3730';
TD 3742';

ABANDONED

County Ellis Elev. _____
 Sec. 1 Twp. 11S Rge. 20W
 Company Petroleum Management (Stableford)
 Farm Name Armbrister No. 1

TOPS	DEPTH	LOG	DATUM	Loc. in Sec.
Anh.				NW SW SE
Tr.				
H.				
Tr.				
Dg.				
Bl.				
L.				Geol. _____
K.C.				Contr. _____
B.K.C.				
Ce.				Sierra
C.				
M.				Pool _____
M.				Warren
K.				
Mz.				
Me.				
V.				
S.				
S.				
A.				
R.				
Pe.				
G.				
T.D.				



Date Comm. 7-26-56 AUG 1 1956
8" 204 w/125; D 2635

(Large handwritten scribble)

AUG 5 1956

R. G.

No. Lse. No. Sec. T. R.

County Ellis Elev. 2142
 Sec. 1 Twp. 11S Rge. 20W
 Company Petroleum Management (Stableford)
 Farm Name Armbrister No. 1

Co.

Loc.

No.

Sec.

T.

R.

	TOPS	DEPTH	LOG	DATUM
Anh.				
TP.				
H.		3375		
Tr.				
Dg.				
Bl.				
L.		3411		
K.C.				
B.K.C.				
Ce.				
C.		3669		
M.				
M.				
K.				
Mz.				
Ma.				
V.				
S.				
S.				
A.		3730		
R.				
PE.				
G.				
TD.		3742		

Loc. in Sec. NW SW SE

Geol. _____
 Contr. Sierra

Pool Warren



Date Comm. 7-26-56 AUG 15 '56

8" 204 w/125; D 2635 AUG 9 '56

DST 3433-57 1hr rec 40' 50cm

BHP 130/20 DST 3457-96

90" rec 307' MSOC SW BHP

240/130" DST 3580-3624

AUG 15 '56 or 90" rec 200' MSW

BHP 955/20" DST 3658-95

45" rec 10' Md BHP 70/20"

DST 3732-42 1hr rec 1680' SW

1100/20" D & C