

Section 1 Township 11 Range 21W

Well No. #1 Staulding (*Spaulding*)

Company Imperial Petroleum

**NORTH**

WEST

**EAST**

**SOUTH**

Trego

KANSAS

Sec. 1 Twp. 11 R. 21W

Well No. #1 Staulding Farm

Imperial Petroleum Company

Wildcat Contractor


           Ft. from N. Line

330' Ft. from S. Line

990' Ft. from E. Line

           Ft. from W. Line

SW SE SW

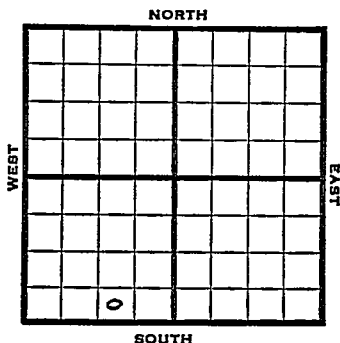

1951

Elev. 2085'

REPORT

12/19

Location

1952

1/2

Spud 12-20-51

D&A TD 3740

8" @ 253'

Heeb. 3343

Tor. 3363


Lans. 3383

Cong. 3618

TD 3740

D&A

**ABANDONED**

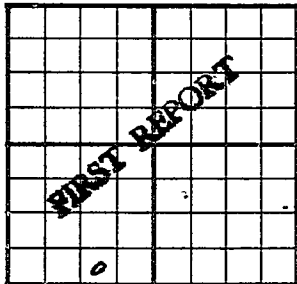County Trego State KansasSec. 1 (Blk.) 11 (Sur.) 21W Map No.Operator Imperial PetroleumWell No. 1 Farm StauldingElev. Location SW SE SW330 Ft. From S Line SW990 Ft. From E Line Quarter1st. Report DEC 1 9 1951


Completion

Remarks Atlantic - DHM

Spudding Date

Drlg. Data WildcatLocationJ. E. TYRA

County Trego State Kansas  
 Sec. 1 (Blk.) 11 (Sur.) 21W Map No.   
 Operator Imperial Petroleum  
 Well No. 1 Farm Spaulding  
 Elev. 2085 Location SW SE SW

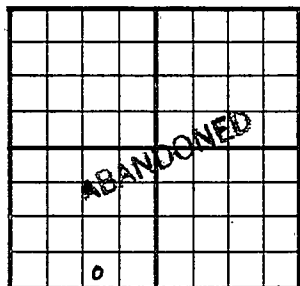

330 Ft. From S Line SW  
990 Ft. From E Line Quarter  
1st. Report  
Completion JAN 2 1952  
Remarks Wildcat

Spudding Date 12-20-51  
Drlg. Data D & A TD 3740

8" @ 253 Heeb. 3343 Tor. 3363  
Lans. 3383 Cong. 3618 TD 3740  
D & A

J. E. TYRA