


FORM 51 25M 3-49 PETROL Trego

Section 1 Township 11 Range 21W

Well No. #1 Spaulding "B"

Company Imperial Drilg.

NORTH

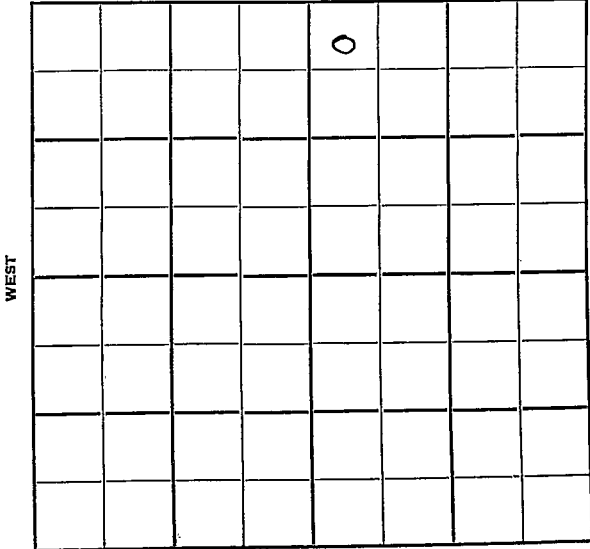

WEST

EAST

SOUTH

Trego

KANSAS

Sec. 1 Twp. 11 R. 21W

Well No. #1 Spaulding "B" Farm

Imperial Drlg. Company

Deek Contractor

Wildcat

330 Ft. from N. Line


_____ Ft. from S. Line

_____ Ft. from E. Line

330 Ft. from W. Line

NE $\frac{1}{4}$ NW NW NE

CSO -DHM

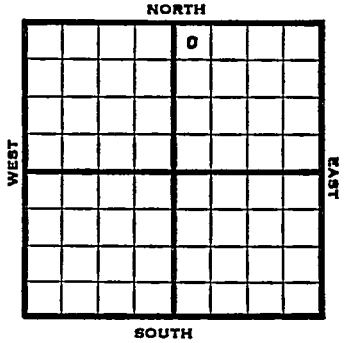

1952 Elev. 2103' REPORT

11/12 RUR

11/20 8" @ 340' Anhy 1530'
Drlg. 3185'

11/27 Heeb 3342, Lans 3382
DST 3530-56, 1 hr., 15' M +
SO
DST 3567-81, 1 hr., 36' ocm, 940#
Arb 5694
TD 3696
DST 369-96, 1/2 hrs., 10' M
5" @ 3696'

12/4 NR

12/11 CO 3697 4 GOPH DP 3699 18 GOPH Dec
to 10 GOPH 500A S/4 BOPH 1st Hr. Dec.
to 2 BOPH in 5 Hrs. DD 3704

12/18 DD 3707 S/1 BOPH

12/25 " " "

1/1 Testing

1/8 NR

1/22 NR

1/29 "

2/5 NR

OVER

#1 Spaulding "B"

1953

2/12 NR

2/19 NR

2/26 NR

3/4 Spud 11-10-52

Oil Well

TD 3727

8" @ 340

Anhy 1530, Heeb 3342, L^uans

3382

DST 3530-56, opn 1 hr., rec. 15'
mud & SO

DST 3567-81, opn 1 hr., rec.

36' ocm, 940#

Arb 3694

TD 3696,

DST 3690-96 opn $\frac{1}{2}$ hr., rec. 10'
mud,

5" @ 3696

CO to 3697

B/4 goph

DD 3699

18 goph, dec. to 10 goph 500A

S/4 boph dec. to 2 boph

DD 3704, DD 3707, S/1 boph

1000A

DD 3715, DD 3727, S/3 bwph

SP 3672, s1/3652-59, S/2 bwph

& SS0, SP 3604

40/3573-80, 2000A

S/50 bo 24 hrs.

P/20 bopd

Comp. 17 bopd 10% wtr.

COMPLETED

County Trego State KansasSec. 1 (Blk. 11) (Sur. 21W) (Twp. 11) (Rge. 21W) Map No.Operator Imperial Drlg.Well No. 1 Farm Spaulding "B"Elev. 2103 Location NW NW NE

330 Ft. From N Line NE330 Ft. From W Line Quarter1st. ReportCompletion MAR A 1953Remarks WildcatDeek - Contr.Spudding Date 11-10-52Drlg. Data Oil well TD 37278" @ 340 Anhy 1530 Heeb. 3342Lans. 3382 DST 3530-56 open 1 hr.Rec. 15' mud & SO DST 3567-81 open 1 hr.Rec. 36' ocm 940# Arb. 3694 TD 3696DST 3690-96 open $\frac{1}{2}$ hr. Rec. 10' mud5" @ 3696 CO to 3697 B/ 4 gophDD 3699 18 goph dec. to 10 goph 500 AS/ 4 boph dec. to 2 boph DD 3704DD 3707 S/ 1 boph 1000 A DD 3715DD 3727 S/ 3 bwph SP 3672 21/ 3652-59S/ 2 bwph & SSO SP 3604 40/ 3573-802000 A S/ 50 bo 24 hr. P/ 20 bopdComp. 17 bopd 10% wtr.

J. G. McGEHEE