


Trego

KANSAS

SECTION 1 TOWNSHIP 11S RANGE 21W

WELL NO. #3 Spaulding "C"

COMPANY Imperial

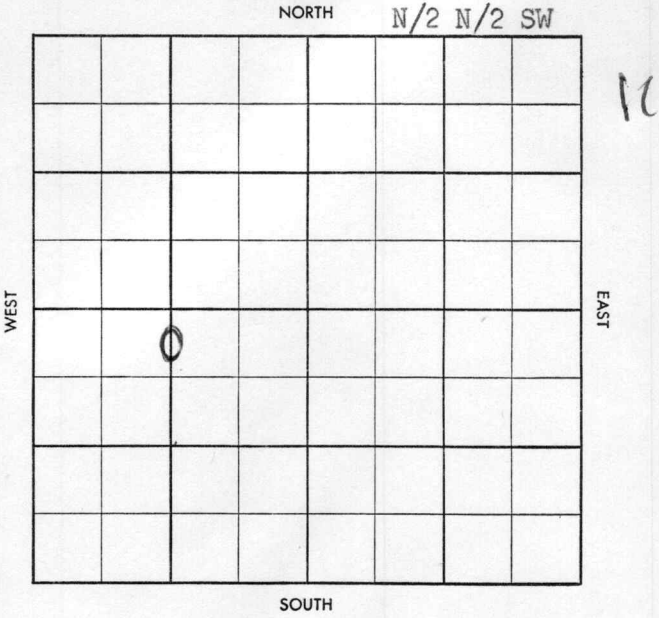

52

County Trego Elev. \_\_\_\_\_

Sec. 1 Twp. 11 Rge. 21W

Company Imperial

Farm Name Spaulding "C" No. 3

TOPS	DEPTH	LOG	DATUM
Anh.			
Tp.			
H.			
Tr.			
Dg.			
B.L.			
L.			
K.C.			
B.K.C.			
Ce.			
C.			
M.			
M.			
K.			
Mz.			
Mq.			
V.			
S.			
S.			
A.			
R.			
Pf.			
G.			
T.D.			

Loc. in Sec. \_\_\_\_\_  
N/2 N/2 SW

Geol. \_\_\_\_\_  
 Contr. \_\_\_\_\_  
K & E Drlg.

Pool \_\_\_\_\_  
Trico



Date Comm. \_\_\_\_\_

Location

\_\_\_\_\_

\_\_\_\_\_

\_\_\_\_\_

\_\_\_\_\_

\_\_\_\_\_

\_\_\_\_\_

\_\_\_\_\_

Co.  
No.  
Sec.  
T.  
R.

Twp. X Pool X  
 Co. X Feet X

S-513-B

Co.

County Trego Elev. 2073 DF 2076 RB  
 Sec. 1 Twp. ~~M~~ Rge. 21W  
 Company Imperial  
 Farm Name Spaulding "C" No. 3

TOPS	DEPTH	LOG	DATUM
Anh.	<u>1520</u>		
Tp.			
H.	<u>3309</u>		
Tr.	<u>3330</u>		
Dg.			
B.L.			
L.			
L.K.C.	<u>3346</u>		
B.K.C.			
Ce.			
C.			
M.			
M.			
K.			
Mz.			
Mq.			
V.			
S.			
S.			
A.	<u>3645</u>		
R.			
Pf.			
G.			
T.D.	<u>3649</u>		

Loc. in Sec. N/2 N/2 SW  
 Geol. \_\_\_\_\_  
 Contr. K & E Drlg. #2  
 Pool Trico  
 COMPLETE  
 0  
 APR 30 '58

No.

Sec.

T.

R.

Date Comm. 2-11-58  
 Location FEB 19 '58 8" 215/175 DST 3414  
-37 60" 60' gap 180' N5W  
BHP 1180 DST 3528 -54 60"  
10' N BHP 30 in no 109  
5" 3648 WOCT FEB 26 '58 MAR 5 '58 DD  
3659 \$1590ph 4 hrs tstg MAR 12 '58  
11 \$980ph +10% w 24 hrs prod  
MAR 19 '58 MAR 26 '58 APR 2 '58 APR 9 '58 APR 16 '58 APR 23 '58  
APR 30 '58 Phys 16' BOPD +10% w  
on 34.6°