


Trego

KANSAS

SECTION 1 TOWNSHIP 11S RANGE 21W

WELL NO. #5 Spaulding "C-D"

COMPANY Imperial

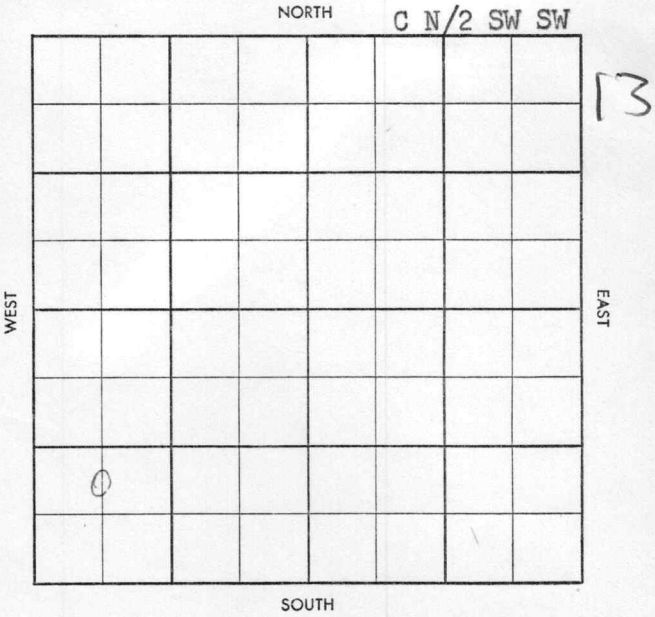

~~Top~~ ~~Pool~~  
~~Co.~~ ~~First~~

S-513-B

County Trego Elev. \_\_\_\_\_  
 Sec. 1 Twp. 11 Rge. 21W  
 Company Imperial  
 Farm Name Spaulding "C-D" No. 5

TOPS	DEPTH	LOG	DATUM
Anh.			
Tp.			
H.			
Tr.			
Dg.			
B.L.			
L.			
K.C.			
B.K.C.			
Ce.			
C.			
M.			
M.			
K.			
Mz.			
Mq.			
V.			
S.			
S.			
A.			
R.			
Pf.			
G.			
T.D.			

Loc. in Sec. \_\_\_\_\_  
C N/2 SW SW  
 Geol. \_\_\_\_\_  
 Contr. \_\_\_\_\_  
Co. Tools  
 Pool \_\_\_\_\_  
Spaulding So.



Date Comm. \_\_\_\_\_  
MIRT  
 \_\_\_\_\_  
 \_\_\_\_\_  
 \_\_\_\_\_  
 \_\_\_\_\_  
 \_\_\_\_\_  
 \_\_\_\_\_  
 \_\_\_\_\_  
 \_\_\_\_\_

Co.  
 Lse.  
 No.  
 Sec.  
 T.  
 R.

~~Top~~ Pool  
 Co. Facet

S-513-B

County Trego Elev. 2258 DE 226198  
 Sec. 1 Twp. 11 Rge. 21W  
 Company Imperial  
 Farm Name Spaulding "C-D" No. 5

TOPS	DEPTH	LOG	DATUM	Loc. in Sec.
Anh.	1508			C N/2 SW SW
Tp.				
H.	3309			
Tr.	3329			
Dg.				
B.L.				
L.	3348			Geol.
K.C.				Contr.
B.K.C.				Co. Tools
Ce.				Pool <u>TRICO</u>
C.				<u>Spaulding Co.</u>
M.				<div style="border: 1px solid black; padding: 5px; display: inline-block;">           COMPLETE             AUG 20 '58         </div>
M.				
K.				
Mz.				
Mq.				
V.				
S.				
S.				
A.	3644			
R.				
Pf.				
G.				
T.D.	3658			

Date Comm. 6-10-58 8" 224/50  
 MIRT JUN 18 '58 \$3560 JUN 25 '58 DST  
3608-48 1hr 10' M BHP 30  
DST 3648-53 1hr 15' 50 cm  
BHP 1030 DST 3653-58 3hrs  
85' 40 cm BHP 940 no log 5"  
3650 wocT <sup>JUL 2 '58</sup> CO 3658 \$  
1/2 Boph NWNT (A) \$ 1.68 Boph NW  
24 hrs (B) \$ 2 1/2 Boph NW 12 hrs pap  
 JUL 9 '58 JUL 16 '58 JUL 23 '58 JUL 30 '58 AUG 6 '58

AUG 13 58

AUG 20 58

Phy Post

76 Bo pd NW

35.5<sup>o</sup>gr

1-11-21W

CN/2 SWSW