


Section 1 Township 11 Range 23W

Well No. #1 C.E. Howat

Company Herman Kaiser

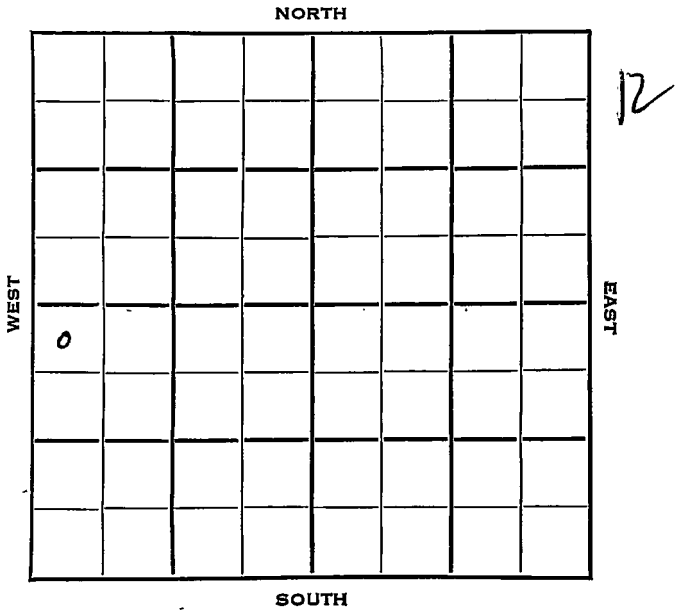

Trego KANSAS

SEC.	TWP.	R.
1	11	23W ✓

WELL NO. _____

COMPANY 1 C. E. Howat FARM

CONTRACTOR Herman Kaiser


Veeder
Wildcat

330 Ft. from N. Line

_____ Ft. from S. Line

_____ Ft. from E. Line

330 <1 Ft. from W. Line

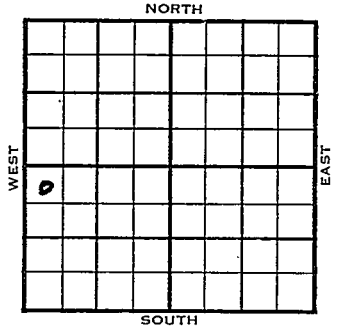

NW NW SW

1954	ELEVATION 2265'	REPORT
------	--------------------	--------

3/10 8" @ 270'

3/17 Drlg. 3420

3/24 Spud 3-9-54
D&A
TD 4040'
8" @ 270'
Heeb 3507'; lans 3543', M arm. 3861',
cong 3930'; Simp. 3977', Arb. 3986'
TD 4040'
D&A

ABANDONED

