


Section 1 Township 11 Range 18-W

Well No. #1 Burnett "E"

Company Wakefield

NORTH Burnett Arb. Pool

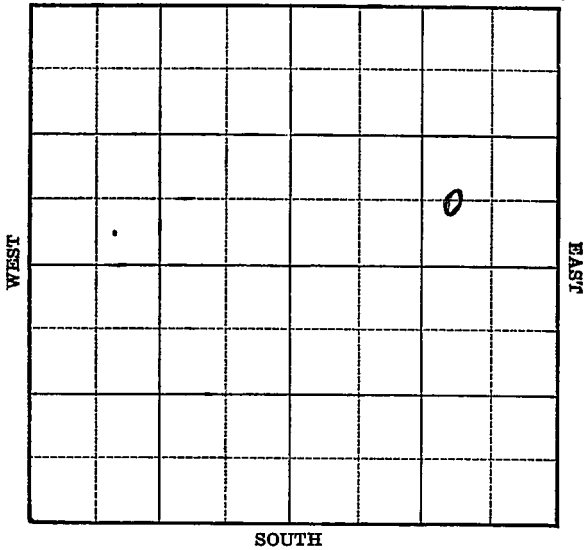

Sec. 1 Twp. 11 R. 18-W

Well No. #1 Burnett "E" Farm

Wakefield Company


(Burnett Arb.)

_____ Ft. from N. Line

660 Ft. from S. Line

990 Ft. from E. Line

_____ Ft. from W. Line

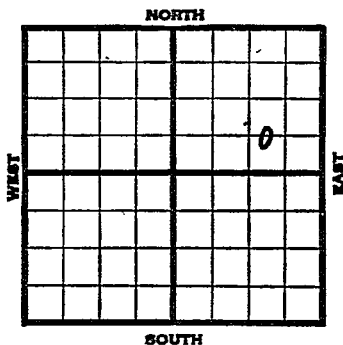

Elev. 2035

1940	REPORT
2/14	S. H.
2/23	13" - 60' 8" - 1309'
	Anhy 1300' Drlg. 2613'
2/29	Drlg. 3446'
3/8	Arb. 3586' T.D. 3587'
	5" - 3586' RUST.
	Simp. 3563' Green shale 3573'
3/14	T.D. 3590' 1800' oil 12 hours.
	3000 acid.
3/20	Arb. 3586'
	5" - 3586'
	T.D. 3590'
	3000 acid.
	Echometer potential 1116 bbls.
	COMPLETED

Map No. 71 Sec. 1 Twp. 11 R. 18WWell No. 1 Burnett "E"Wakefield

Company

Contractor

FIRST REPORT

C W L S E N E

SECTION PLAT

			o

 Ft. from N. Line660 Ft. from S. Line990 Ft. from E. Line Ft. from W. Line

BURNETT ARB? POOL

Location Rig up

Drilling and Remarks:

S.H.

RECORD

Cased in., ft.Sand Gas Oil Total Depth

PRODUCTION

1st 24 hrs. Nat. 1st 24 hrs. after shot Gas Cu. Ft.Dry Hole Abandoned

Date

FEB 14 1940 19

S. J. LEWIS Scout

Map No. 71 Sec. 1 Twp. 11 R. 18WWell No. 1 Burnett "E"Wakefield

Company

Contractor

COMPLETED

C W L S E N E

 Ft. from N. Line660 Ft. from S. Line990 Ft. from E. Line Ft. from W. Line

SECTION PLAT

			o

BURNETT ARB. POOL

Location Rig up

Drilling and Remarks:

*Cor 83586**5" c 8586**2000 acid**Echometer P.S.**1116*

RECORD

Cased in., ft.Sand Gas Oil Total Depth 3590

PRODUCTION

1st-24 hrs. Nat. 1st 24 hrs. after shot Gas Cu. Ft.Dry Hole Abandoned

Date

MAR 20 1940 19

S. J. LEWIS Scout