


Section 10 Township 11 Range 18-W

Well No. #1 Holler

Company B & R Drlg.

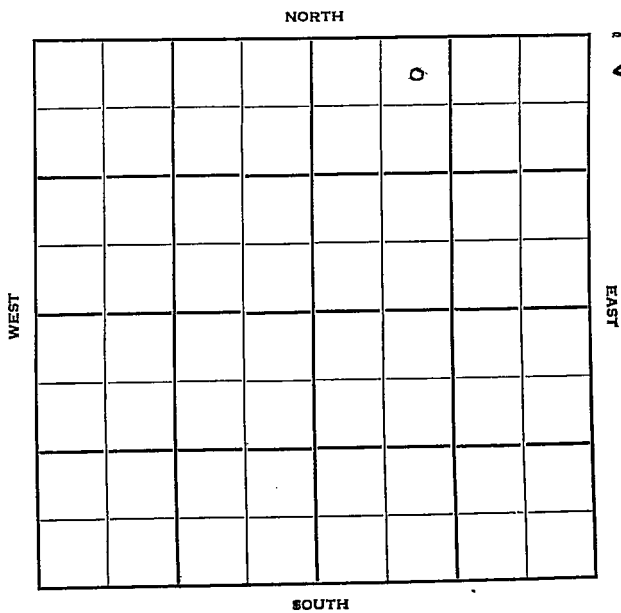

Sec. 10 Twp. 11 R. 18W ✓

Well No. #1 Holler Farm

B & R Drlg. Company

Contractor


330' Ft. from N. Line

_____ Ft. from S. Line

_____ Ft. from E. Line

990' Ft. from W. Line

NE NW NE

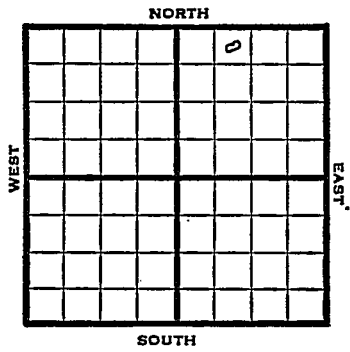

1950 Elev 1961 REPORT

6/28 Spud 6-24-50
 8" @ 222'
 Drlg. 750'

7/12 8" @ 222
 Topeka 2956
 Lans 3330
 Simp 3545
 TD 3571
 D&A

Heeb 3185
 Cong 3455

ABANDONED

Map No. _____ Sec. 10 Twp. 11 R. 18W

Well No. 1 Holler

_____ B & R Drlg. _____ Company

_____ Contractor

NE NW NE

330 Ft. from N. Line

_____ Ft. from S. Line

_____ Ft. from E. Line

990 Ft. from W. Line

SECTION PLAT

		o	
FIRST REPORT			

Ellis County

Location _____

Rig up _____

Drilling and Remarks:

Spud 6-24-50

8" C 222

drlg. 750

RECORD

Cased _____ in., _____ ft.

Sand _____

Gas _____

Oil _____

Total Depth _____

PRODUCTION

1st 24 hrs. Nat. _____

1st 24 hrs. after shot _____

Gas _____ Cu. Ft.

Dry Hole _____

Abandoned _____

Date

JUN 28 1950 19

J. E. TYRA Scout

Map No. _____ Sec. 10 Twp. 11 R. 18W

Well No. 1 Holler

B & R Drlg. Company

Contractor

El. 1961

SECTION PLAT

NE NW NE

330 Ft. from N. Line

_____ Ft. from S. Line

_____ Ft. from E. Line

990 Ft. from W. Line

		0	
	ABANDONED		

Ellis County

RECORD

Location _____

Cased _____ in., _____ ft.

Rig up _____

Sand _____

Drilling and Remarks:

Gas _____

8" C 222

Oil _____

Topeka 2956

Total Depth 3571

Heeb. 3185

PRODUCTION

Lans. 3330

1st 24 hrs. Nat. _____

Cong. 3455

1st 24 hrs. after shot _____

Gas _____ Cu. Ft.

Simp. 3545

Dry Hole _____

Abandoned _____

Date D & A

JUL 12 1955 19

J. E. TYRA Scout