

KANSAS


Form 51-5M-4-36-Palace

Ellis

Section 10 Township 11 Range 18-W

Well Number #1 Haller

Company Minnehoma O & G

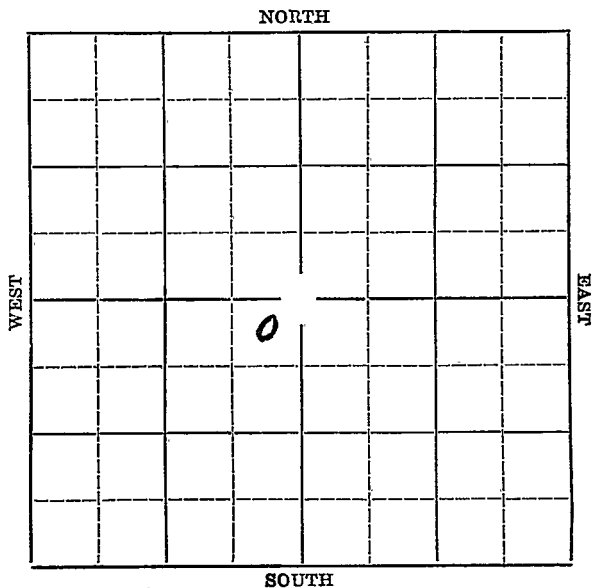

Sec. 10 Twp. 11 R. 18W

Well No. #1 Haller Farm
Minnehoma O & G Company


330' Ft. from N. Line

_____ Ft. from S. Line

330' Ft. from E. Line

_____ Ft. from W. Line

Elev. 1894

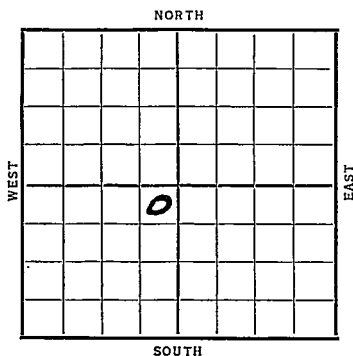

~~1936~~

REPORT

10/21	Rig on ground.
10/29	Rigging up.
11/6	Drlg. 1100
11/12	20" @ 48 12" @ 1210 Drlg. 1570'.
11/19	Drlg. 2755'.
11/27	Topeka 2915'. 7" @ 3040' Rust.
12/3	Drlg. 3140'.
12/10	Drlg. 3240'.
12/17	Sil. 3414'. T. D. 3417'. Run 5" .
12/29	Sil 3492'. (Corrected) T. D. 3501'. H. F. W.

ABANDONED

KANSAS

Map No. 71 Sec. 10 Twp. 11 R. 18W

Well No. 1 Hatter

Minnesota O & G Company

Contractor

SECTION PLAT

330 Ft. from N. Line

_____ Ft. from S. Line

370 Ft. from E. Line

_____ Ft. from W. Line

		0	

FIRST REPORT

Location _____

Rig up _____

Drilling and Remarks:

ROG

RECORD

Cased _____ in., _____ ft.

Sand _____

Gas _____

Oil _____

Total Depth _____

PRODUCTION

1st 24 hrs. Nat. _____

1st 24 hrs. after shot _____

Gas _____ Cu. Ft.

Dry Hole _____

Abandoned _____

Date

Oct 1 1936

19

S. J. LEWIS Scout

Map No. 71 Sec. 10 Twp. 11 R. 18W

Well No. 1 Neller

Minneapolis O & G Company

Contractor

SECTION PLAT

330 Ft. from N. Line

_____ Ft. from S. Line

330 Ft. from E. Line

_____ Ft. from W. Line

ABANDONED

		0	

Location _____

Rig up _____

Drilling and Remarks:

Oil 13492 collected

AFW

DAH

RECORD

Cased _____ in., _____ ft.

Sand _____

Gas _____

Oil _____

Total Depth 3501

PRODUCTION

1st 24 hrs. Nat. _____

1st 24 hrs. after shot _____

Gas _____ Cu. Ft.

Dry Hole _____

Abandoned _____

Date

DEC 29 1936 19

S. J. LEWIS Scout