

Ellis

KANSAS

SECTION 10 TOWNSHIP 11 RANGE 20W

WELL NO. #1 Yohe

COMPANY Carl Todd

NORTH

18

WEST

EAST

SOUTH

0

Ellis

KANSAS


SEC.	TWP.	R.
10	11	20 W

WELL NO. # 1 Yohe FARM

COMPANY
 CONTRACTOR Carl Todd

Co. tools
 Eagle Creek

_____ Ft. from N. Line
 _____ Ft. from S. Line
 _____ Ft. from E. Line
 _____ Ft. from W. Line

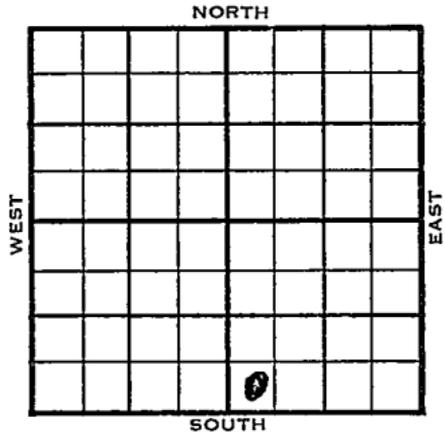

SW SW SE

SDX Lse 1/2 Mile

1956	ELEVATION 1997'	REPORT
------	-----------------	--------

5/9 MIR
 5-17 Spud 5-7-56
 8 5/8" @ 252 w/100
 Anhy 1435, Heeb. 3276, Lans. 3316'
 Drlg. 3428'
 5-23 DST 3470-97 op 1 hr. rec. 15' mud,
 BHP ?.
 D & A
 BKC 3537', C. 3586', S. 3643', A. 3660'
 TD 3710'

ABANDONED

County Ellis Elev. _____
 Sec. 10 Twp. 11 Rge. 20W
 Company Carl Todd
 Farm Name Yone No. 1

TOPS	DEPTH	LOG	DATUM
Anh.			
Tp.			
H.			
Tr.			
Dg.			
Bl.			
L.			
K.C.			
B.K.C.			
Ce.			
C.			
M.			
M.			
K.			
Mz.			
Mo.			
V.			
S.			
S.			
A.			
R.			
Pe.			
G.			
T.D.			

Loc. in Sec. SW SW SE
 Geol. _____
 Contr. _____
 Co. tools _____
 Pool _____
Earle Creek

1/2 11/11/56
FIRST REPORT
 MAY 9 '56
0

Date Comm. MIR

BEER & WASH

BEER

Co.
 Use.
 No.
 Sec.
 T.
 R.

