


Ellis

Section 10 Township 11 Range 20W

Well No. #2 Yohe

Company M & L Oil

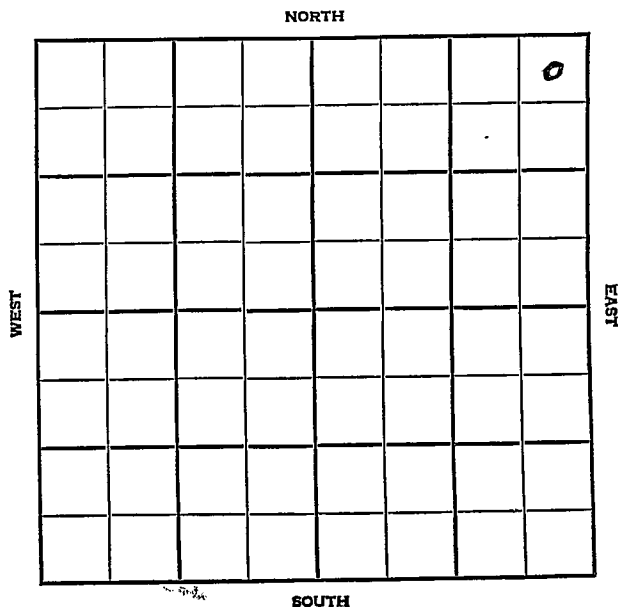

Ellis

KANSAS


|      |      |     |
|------|------|-----|
| SEC. | TWP. | R.  |
| 10   | 11   | 20W |

WELL NO. 2 Yohe FARM

COMPANY M & L Oil

CONTRACTOR Lewis Drlg. Warren

440 Ft. from N. Line  
 \_\_\_\_\_ Ft. from S. Line  
 280 Ft. from E. Line  
 \_\_\_\_\_ Ft. from W. Line

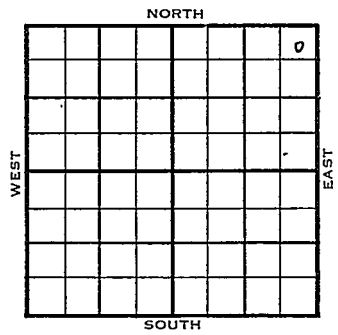

NE NE NE

| 1955 | ELEVATION | REPORT |
|------|-----------|--------|
|      | 2054      |        |

6/22 C & P

8/31 Comm 6-25-55  
 Anh 1470  
 TP 3077  
 H 3292  
 BL 3316  
 L 3329  
 C 3574  
 S 3625  
 A 3648  
 TD 3650

8 5/8" @ 228/150 DST 3329-72 open  
 1 hr Rec 780' gas 1325' oil 900#  
 DST 3409-20 open 1 hr Rec 600' gas  
 825' oil 1155# 5 1/2" @ 3649/135  
 CO 40/3379-85 S/2 boph FU 1300'  
 oil 9 hr 3000 A S/188 bo 3 1/2 hr.  
 S/31 boph Comp BHP 632 bopd

**COMPLETED**

County Ellis Elev. \_\_\_\_\_  
 Sec. 10 Twp. 11 Rge. 20W  
 Company M & L Oil  
 Farm Name Yohe No. 2

| TOPS   | DEPTH | LOG | DATUM |
|--------|-------|-----|-------|
| Anh.   |       |     |       |
| Tp.    |       |     |       |
| H.     |       |     |       |
| Tr.    |       |     |       |
| Dg.    |       |     |       |
| Bl.    |       |     |       |
| L.     |       |     |       |
| K.C.   |       |     |       |
| B.K.C. |       |     |       |
| Ce.    |       |     |       |
| C.     |       |     |       |
| M.     |       |     |       |
| M.     |       |     |       |
| K.     |       |     |       |
| Mz.    |       |     |       |
| Ma.    |       |     |       |
| V.     |       |     |       |
| S.     |       |     |       |
| S.     |       |     |       |
| A.     |       |     |       |
| R.     |       |     |       |
| PE.    |       |     |       |
| G.     |       |     |       |
| T.D.   |       |     |       |

Loc. in Sec. \_\_\_\_\_  
NE NE NE  
440' NL  
280' EL  
 Geol. \_\_\_\_\_  
 Contr. \_\_\_\_\_  
Lewis Drlg.  
 Pool \_\_\_\_\_  
Warren

|  |  |   |
|--|--|---|
|  |  | 0 |
|  |  |   |
|  |  |   |

**FIRST REPORT**  
 JUN 22 '55

Date Comm. \_\_\_\_\_  
Cellar & pits


\_\_\_\_\_  
 \_\_\_\_\_  
 \_\_\_\_\_  
 \_\_\_\_\_  
 \_\_\_\_\_  
 \_\_\_\_\_

Co.  
Lse.  
No.  
Sec.  
T.  
R.

County Elvis Elev. 2054  
 Sec. 10 Twp. 11 Rge. 20W  
 Company M & L Oil  
 FarmName Yohe No. 2

| TOPS   | DEPTH | LOG | DATUM |
|--------|-------|-----|-------|
| Anh.   | 1470  |     |       |
| TP.    | 3077  |     | 1023  |
| H.     | 3292  |     | 1238  |
| Tr.    |       |     |       |
| Dg.    |       |     |       |
| Bl.    | 3316  |     | 1262  |
| L.     | 3329  |     | 1275  |
| K.C.   |       |     |       |
| B.K.C. |       |     |       |
| Ce.    |       |     |       |
| C.     | 3574  |     | 1520  |
| M.     |       |     |       |
| M.     |       |     |       |
| K.     |       |     |       |
| Mz.    |       |     |       |
| Me.    |       |     |       |
| V.     |       |     |       |
| S.     | 3625  |     | 1571  |
| S.     |       |     |       |
| A.     | 3648  |     | 1594  |
| R.     |       |     |       |
| PE.    |       |     |       |
| G.     |       |     |       |
| T.D.   | 3650  |     |       |

Loc. in Sec. NE NE NE  
1410' NI.  
280' EL  
 Geol. \_\_\_\_\_  
 Contr \_\_\_\_\_  
Lewis Drlg.  
 Pool \_\_\_\_\_  
Warren

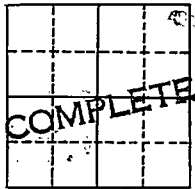

Date Comm. 6-25-55 AUG 3 1955  
8 5/8" @ 228/150 DST 3329-72.. open  
1 hr. Rec. 780' gas 1325' oil 900#  
DST 3109-20 open 1 hr. Rec. 600' gas  
825' oil 1155# 5 1/2" @ 3649/135  
CO 40/ 3379-85 S/2 boph FU 1300' oil  
9 hr. 3000 A S/ 188 bo 3 1/2 hr.  
S/ 31 boph Comp. BHB 632 bopd

Co.  
 Sec.  
 No.  
 Sec.  
 T.  
 R.