


SECTION 10 TOWNSHIP 11S RANGE 23W

WELL NO. #1 Galloway

COMPANY Icer Addis

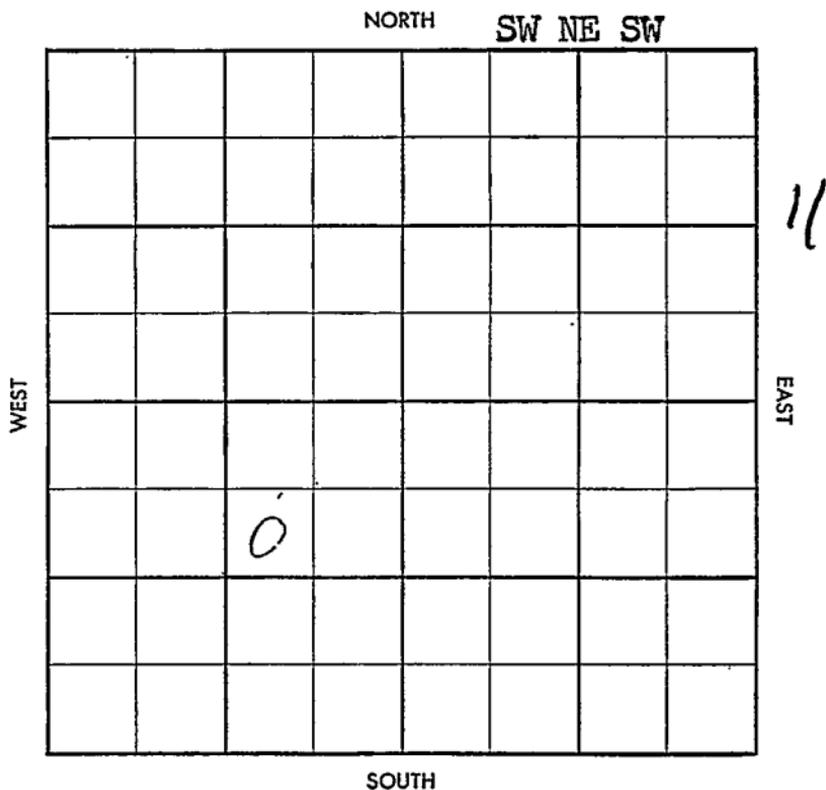

~~Twp.~~ ~~Pool~~
~~Co.~~ ~~Facst.~~

S-513-B

County Trego Elev. _____
 Sec. 10 Twp. 11 Rge. 23W
 Company Icer Addis
 Farm Name Galloway No. 1

TOPS	DEPTH	LOG	DATUM
Anh.			
Tp.			
H.			
Tr.			
Dg.			
B.L.			
L.			
K.C.			
B.K.C.			
Ce.			
C.			
M.			
M.			
K.			
Mz.			
Mq.			
V.			
S.			
S.			
A.			
R.			
Pf.			
G.			
T.D.			

Loc. in Sec. SW NE SW
 Geol. Vaughan
 Contr. _____
Triangle
 Pool _____
Wakeeney NW

AUG 8 1958
FIRST REPORT

Date Comm. 8-3-58
8" @ 217 w/175, Drlg. 1575.

Co.
 Sec.
 T.
 R.

