


Section 10 Township 11 Range 32W

Well No. #1 Harry Johnson

Company B & R Drlg. Co.

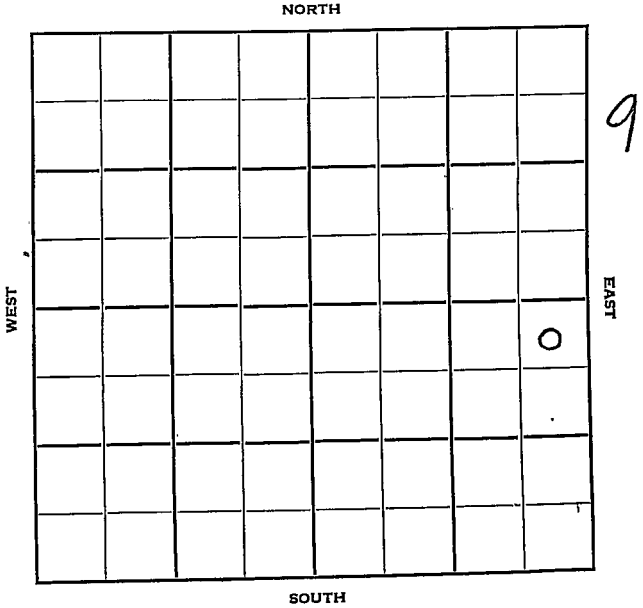

Logan

KANSAS

Sec. 10 Twp. 11 R. 32W

Well No. #1 Harry Johnson Farm

B & R Drlg. Co. Company

Contractor

Wildcat


330' Ft. from N. Line

\_\_\_\_\_ Ft. from S. Line

330' Ft. from E. Line

\_\_\_\_\_ Ft. from W. Line

NE NE SE

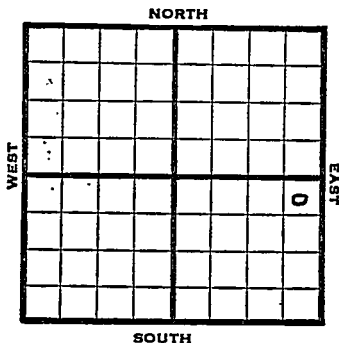

1952

Elev. 3045'

REPORT

7/16

RU

7/23

8" @ 224' w/135 sks.

Drlg. 3410'

7/30

Heeb 4009' Lans. 4044'

DST 4081-89, 3/4 hr, 30' M Off

DST 4103-48, 1 hr, 50' GCM, 30' OCM

1140#

DST 4222-68, 1/2 hr, 45' M Off

SO 4331' B KC 4335'

Drlg. 4443'

8/6

Spud 7-15-52

D & A TD 4800' 8" @ 224

Heeb 4009' Lans. 4044'

DST 4081-89 open 3/4 hr. rec 30' mud Off

DST 4103-48 open 1 hr. rec 50' GCM

30' OCM 1140#

DST 4222-68 open 1/2 hr. rec 15' mud Off

B KC 4335' Cong. 4605' Miss 4646'

TD 4800' D & A

**ABANDONED**



