


Section 10 Township 11 Range 17W

Well No. #1 Richmond

Company Glen Nye Drlg.

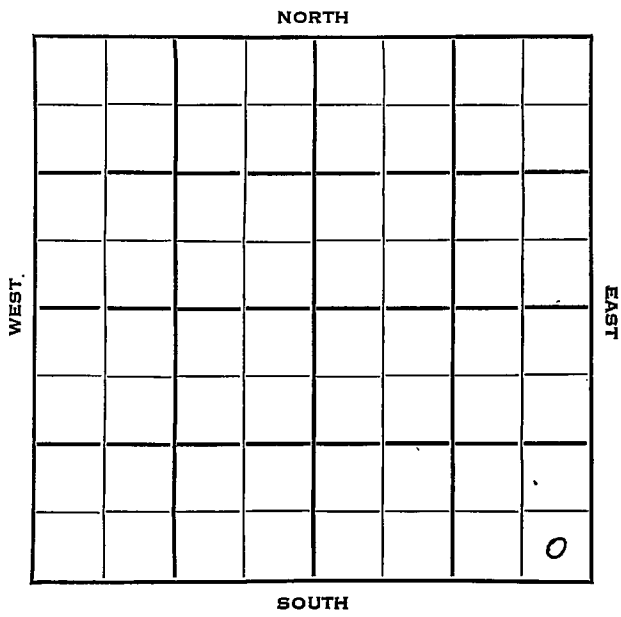

16

0

Sec. 10 Twp. 11 R. 17W

Well No. #1 Richmond Farm

Glen Nye Drlg. Company

Contractor


         Ft. from N. Line

330 Ft. from S. Line

330 Ft. from E. Line

         Ft. from W. Line

SE SE SE  
Derby - DHM

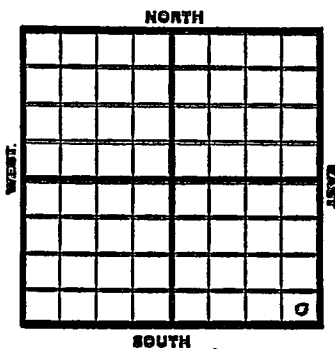

1953 Elev. 1794' REPORT

9/2 Spud 8-27-53  
8" @ 137  
Drlg. 540'

9/9 Heeb 2973, Tor 2991  
DST 2993-3012, 33", 27' SOCM,  
Lans 3015  
Drlg. 3250'

9/16 Spud 8-27-53 D & A TD 3371  
8" @ 137 Heeb 2973 Tor 2991  
DST 2993-3012 open 33 min rec 27'  
SOCM O# Lans 3015 Arb. 3365  
TD 3371' D & A

**ABANDONED**



