

Section 10 Township 11 Range 17W

Well No. #1 Simpson

Company Ray Anderson & Strain Drlg.

NORTH

	0						

12

WEST

EAST

SOUTH

Sec. 10 Twp. 11 R. 17 W

Well No. # 1 Simpson Farm

Ray Anderson & Strain Drlg. Company

Wildcat Contractor


330 Ft. from N. Line

Ft. from S. Line

Ft. from E. Line

990 Ft. from W. Line

NE NW SW

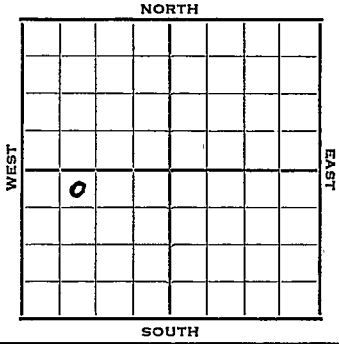

1952 Elev. 1802' REPORT

9/24 Spud 9-14-52
 8" @ 1032' Anhy 1017' Top. 2752'
 Heeb 2984' Tor. 3007' Lans. 3029'
 SO 3116-20'
 DST 3109-22, open 1 hr.

10/1 DST 3125-37, 1 hr., 1800' gas, 210' oil, 60' OCM 940#
 Cong 3315
 DST 3302-21 1/2 hr., 9' M 2' oil 640#
 Arb 3388
 RTD 3390

10/8 Cleaned out to 3664
 36/3317-26, 4000A
 POP

10/15 "

10/22 DST 3112-25, 1 hr., 930' gas, 60' OCM, 210 gco 940# POP P/50 BOPD
 dec. to 17 BOPD

10/29 NR
 11/5 Spud 9-14-52
 D&A TD 3390 8" @ 1032
 Anhy 1017 Top. 2752
 Heeb. 2984 Tor. 3007
 Lans. 3029 SO 3116-20

OVER

1952

11/5

DST 3109-22 open 1 hr. rec. 1800' gas
210' oil 60' ocm 940#

Cong. 3315

DST 3302-21 open $\frac{1}{2}$ hr. rec. 9' mud
2' oil 640# Arb. 3388

5" @ 3388' TD 3390 .60 to 3364

36/ 3317-26 4000 A

DST 3312-25 open 1 hr. rec. 930'
gas 60' ocm 210' gco 940#

P/ 50 bopd dec. to 17 bopd

dec. to 5 bopd D&A

*

ABANDONED

County **Ellis** State **Kansas**

Sec. **10** (Blk. Twp.) **11** (Sur. Rge.) **17W** Map No.

Operator **Ray Anderson & Strain Drlg.**

Well No. **1** Farm **Simpson**

Elev. **1802** Location **NE NW SW**

330 Ft. From **N** Line **SW**

990 Ft. From **W** Line **Quarter**

1st. Report **SEP 24 1952**

Completion _____

Remarks _____

Spudding Date **9-14-52**

Drlg. Data **Wildcat**

8" @ 1032 Anhy 1017 Top. 2752

Heeb. 2984 Tor. 3007 Lans. 3029


SO 3116-20 DST 3109-22 open 1 hr.

J. G. McGEHEE

SEP 26 1952

Scout Cards	mm
Land Bm. Map	
Land & Water map	5
Navigation	
France Map	
Pierce Map	
Misc.	

Orig. Date

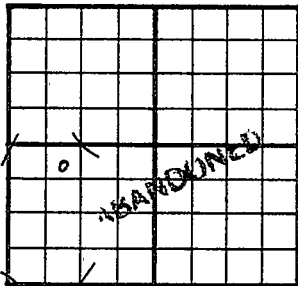County Ellis State KansasSec. 10 (Blk.
Twp.) 11 (Sur.
Rge.) 17W Map No.Operator Ray Anderson & Strain Drlg.Well No. 1 Farm SimpsonElev. 1802 Location NE NW SW330 Ft. From N Line SW990 Ft. From W Line Quarter

1st. Report

Completion NOV 5 1952Remarks WildcatSpudding Date 9-14-52Drlg. Data D & A TD 33908" @ 1032 Anhy 1017 Top. 2752Heeb. 2984 Tor. 3007 Lans. 3029SO 3116-20 DST 3109-22 open 1 hr.Rec. 1800' gas 210' oil 60' ocm 940#Cong. 3315 DST 3302-21 open $\frac{1}{2}$ hr.Rec. 9' mud 20' oil 640# Arb. 33885" @ 3388 TD 3390 CO to 336436/ 3317-26 4000 A DST 3112-25open 1 hr. Rec. 930' gas 60' ocm210' gco 940# P/ 50 bopddec. to 17 bopd dec. to 5 bopdD & A

Scout Cards	W
Land Small Map	
Land Wall Map	3
Tracings	
France Map	
Pierce Map	
Misc	

NOV 12 1952