


Ellis

KANSAS

SECTION 10 TOWNSHIP 11 RANGE 17W

WELL NO. #1 E.A. Richmond

COMPANY Tenn. Gas Trans.

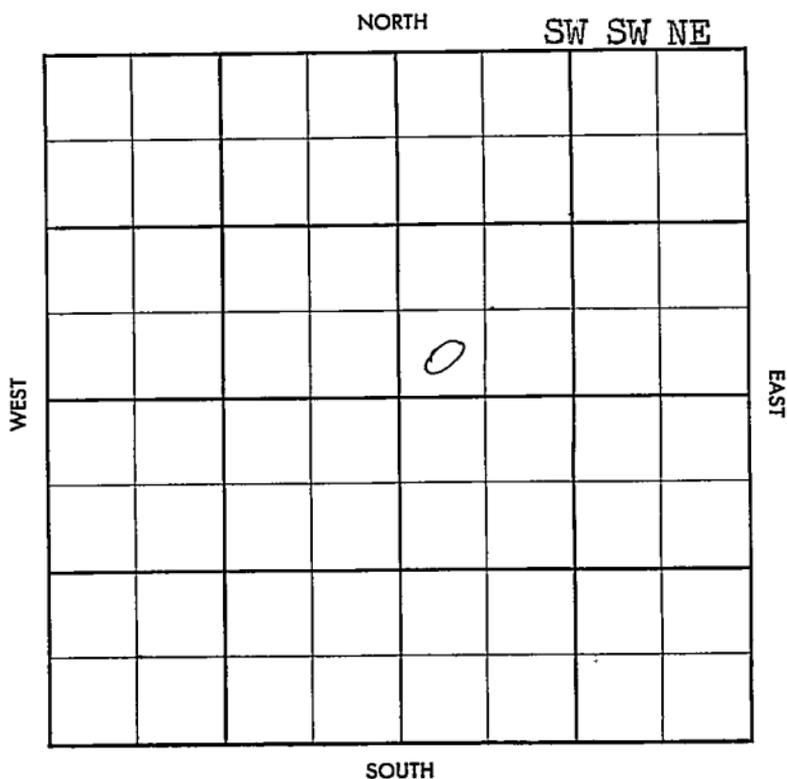

WILDCAT

FORM 513 SUNRAY

County Ellis Elev. _____
 Sec. 10 Twp. 11 Rgs. 17W
 Company Tenn. Gas Trans.
 Farm Name E. A. Richmond No. 1

TOPS	DEPTH	LOG	DATUM
Anh.			
Tp.			
H.			
Tr.			
Dg.			
Bl.			
L.			
K.C.			
B.K.C.			
Ce.			
C.			
M.			
M.			
K.			
Mz.			
Mo.			
V.			
S.			
S.			
A.			
R.			
Pe.			
G.			
T.D.			

Loc. in Sec. SW-SW NE
 Geol. _____
 Contr. _____
 Pool Semi-WC

FIRST REPORT
 JUN 12 '57

Date Comm. _____
 Location _____

[Large handwritten scribble]

Co.
Lse.
No.
Sec.
T.
R.

County Ellis Elev. 1825 DF
 Sec. 10 Twp. 11 Rge. 17W
 Company Perm. Gas Trans.
 Farm Name E. A. Richmond No. 1

TOPS	DEPTH	LOG	DATUM
Anh.	<u>1043</u>		
Tp.	<u>2773</u>		
H.	<u>3008</u>		
Tr.	<u>3029</u>		
Dg.			
Bl.			
L.	<u>3050</u>		
K.C.			
B.K.C.			
Ce.			
C.	<u>3334</u>		
M.			
M.			
K.			
Mz.			
Ma.			
V.			
S.	<u>3364</u>		
S.			
A.	<u>3400</u>		
R.			
PE.			
G.			
TD.	<u>3440</u>		

Loc in Sec _____
 SW SW NE
 Geol. claudesheets
 Contr. Shelley-Miller
 Pool _____
 Series 1-13

ABANDONED
 0
 JUL 17 57

Date Comm. _____

Location W 19 '77

Spd 7-1-57 8578 244/175 WOC
AN 10 45 Anh 1043 D 3120
X Tp 2773 Hb 3008 Tr 3029 Ls 9
3050 DST 3080 - 3135 up 45"
see 13' Md BHP 345/20" DST 3132
-70 up 1hr see 87' WM 1 BHP 1017
FBHP 915 FP 35-73 C 9 3334
DST 3332 - 60 up 1hr see 135' 50 CM SW

FP 90-100 1BHP 1170 FBHP
990 SP 3364 A16 3400 RTD
3440 Ran Log DEQ

Rig stacked

10-11-74

sw sw ne