

KANSAS


Russell

FORM 51 5M 1-42 PETROL

Section 11 Township 11 Range 14-W

Well No. #1 L. E. Beverly

Company Northern Ordnance

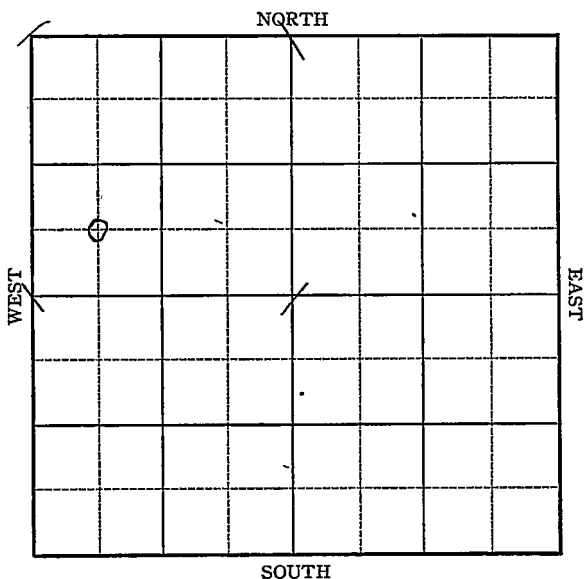

KANSAS


Russell

Sec. 11 Twp. 11 R. 14-WWell No. #1 L. E. Beverly FarmNorthern Ordance Company

Wildcat

 Ft. from N. Line660 Ft. from S. Line Ft. from E. Line660 Ft. from W. Line

Elev. 1788

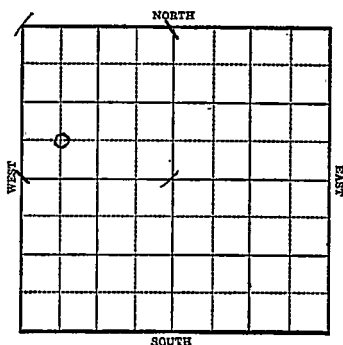

1943

R E P O R T

4/21 103/4"-248' Waiting on cement
Carter oil Farmout4/28 Anhy 925
Ft. Riley 1815
Neva 265
Drlg. 2410'5/5 Topeka 2730
Lans 3060
Drlg. 33665/12 Congl. 3465
Viola 3525
Arb. 3683
T.D. 3738'**ABANDONED**

Russell

Map No. **KANSAS** Sec. **11** Twp. **11** R. **14W**

Well No. **1 L. E. Beverly**

Northern Ordnance Company

FIRST REPORT Contractor

C SW NW


SECTION PLAT

_____ Ft. from N. Line

660 Ft. from S. Line

_____ Ft. from E. Line

660 Ft. from W. Line

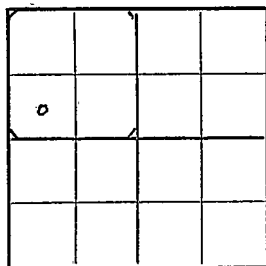

WILDCAT

Location _____

Rig up _____

Drilling and Remarks:

**Carter Oil
Farmout**

10 $\frac{3}{4}$ " -248'

**Waiting on
Cement**

RECORD

Cased _____ in., _____ ft.

Sand _____

Gas _____

Oil _____

Total Depth _____

PRODUCTION

1st 24 hrs. Nat. _____

1st 24 hrs. after shot _____

Gas _____ Cu. Ft.

Dry Hole _____

Abandoned _____

Date

APR 2 1 1943 19

S. J. LEWIS Scout

Russell

KANSAS
 Map No. 72 Sec. 11 Twp. 11 R. 14W

Well No. 1 L. E. Beverly

Northern Ordnance Company

ABANDONED Contractor

C SW NW

SECTION PLAT

 Ft. from N. Line

660 Ft. from S. Line

 Ft. from E. Line

660 Ft. from W. Line

6			

WILDCAT

Location

Rig up

Drilling and Remarks:

Core L. 3465
Net L. 3525
Core 3683

RECORD

Cased in., ft.

Sand

Gas

Oil

Total Depth 2288

PRODUCTION

1st 24 hrs. Nat.

1st 24 hrs. after shot

Gas Cu. Ft.

Dry Hole

Abandoned

Date

MAY 12 1943 19

S. J. LEWIS Scout