

KANSAS

Ellis

Form 51-5M-7-40-Palace


Section 11 Township 11 Range 18-W

Well No. #2 Carmichael

Company Nadel & Gussman

Koblitz Pool

NORTH

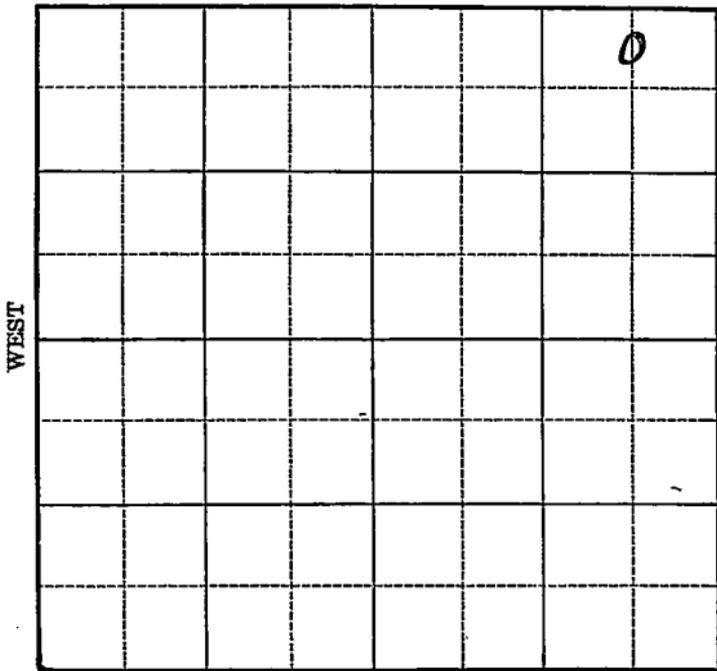

SOUTH

WEST

EAST

Map No. 71 Sec. 11 Twp. 11 R. 18WWell No. 2 CarmichaelNadel & Gussman Company

Contractor

FIRST REPORTC $N\frac{1}{2}$ NE NE330 Ft. from N. Line Ft. from S. Line630 Ft. from E. Line Ft. from W. Line

KOBELITZ POOL

SECTION PLAT

			o
		.	

Location Rig up

Drilling and Remarks:

Rotary

RECORDCased in., ft.Sand Gas Oil Total Depth **PRODUCTION**1st 24 hrs. Nat. 1st 24 hrs. after shot Gas Cu. Ft.Dry Hole Abandoned

Date

SEP 25 1940 19S. J. LEWIS Scout

Map No. 71 Sec. 11 Twp. 11 R. 18WWell No. 2 Carmichael
Nadel & Gussman Company

Contractor

ABANDONED**SECTION PLAT**C $N\frac{1}{2}$ NE NE330 Ft. from N. Line Ft. from S. Line630 Ft. from E. Line Ft. from W. Line

KOBELITZ POOL

			o

Location Rig up

Drilling and Remarks:

*Cor # 3475**No shows***RECORD**Cased in., ft.Sand Gas Oil Total Depth 3478**PRODUCTION**1st 24 hrs. Nat. 1st 24 hrs. after shot Gas Cu. Ft.Dry Hole Abandoned

Date

OCT 16 1940

19S. J. LEWIS Scout