

KANSAS

FORM 51 5M 4-41 PETROL


Ellis

Section 11 Township 11 Range 18-W

Well No. #3 Carmichael

Company Nadel & Gussman

Burnett Pool

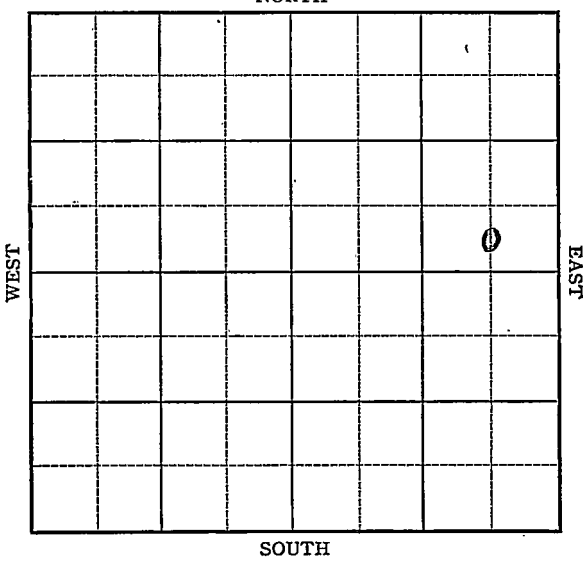

Sec. 11 Twp. 11 R. 18-W

Well No. #3 Carmichael Farm

Nadel & Gusman Company


(Burnett)

_____ Ft. from N. Line

330 Ft. from S. Line

660 Ft. from E. Line

_____ Ft. from W. Line

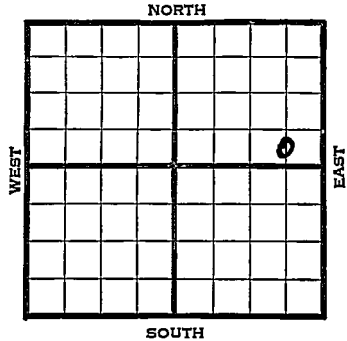

Elev. 1898

1941	REPORT
4/9	Derrick.
4/18	Anhg 1160' 8-5/8" - 1172'
	Drlg. 1585'
4/24	Drlg. 3041'
5/1	Arb. 3395' 5" - 3395'
	T.D. 3402' 2900' oil 1 1/2 hours.
5/7	Arb. 3395'
	5" - 3395'
	T.D. 3402'
	500 acid.
	Echometer potential 13,800 bbls.
	Maximum 3000 bbls.
	32. Gravity
	COMPLETED

Map No. 71 Sec. 11 Twp. 11 R. 18W

Well No. 3 Carmichael

Nadel & Gussman Company

FIRST REPORT Contractor

C S L SE NE

 Ft. from N. Line

330 Ft. from S. Line

660 Ft. from E. Line

 Ft. from W. Line

SECTION PLAT

			•

BURNETT POOL

Location

Rig up

Drilling and Remarks:

Derrick

RECORD

Cased in., ft.

Sand

Gas

Oil

Total Depth

PRODUCTION

1st 24 hrs. Nat.

1st 24 hrs. after shot

Gas Cu. Ft.

Dry Hole

Abandoned

Date

APR 9 1944 19

S. J. LEWIS Scout

Map No. 71 Sec. 11 Twp. 11 R. 18W

Well No. 3 Carmichael

Nadel & Gussman Company

COMPLETED Contractor

SECTION PLAT

C S L SE NE

_____ Ft. from N. Line

330 Ft. from S. Line

660 Ft. from E. Line

_____ Ft. from W. Line

BURNETT POOL

Location _____

Rig up _____

Drilling and Remarks:

Core 43395.
5 43395
500 acid
Ech 124.13500
Map 3000

32° Gr

RECORD

Cased _____ in., _____ ft.

Sand _____

Gas _____

Oil _____

Total Depth 3402

PRODUCTION

1st 24 hrs. Nat. _____

1st 24 hrs. after shot _____

Gas _____ Cu. Ft.

Dry Hole _____

Abandoned _____

Date

MAY 7 1941 19

S. J. LEWIS Scout