

KANSAS

Form 51-5M-7-40-Palace


Ellis

Section 11 Township 11 Range 18-W

Well No. #2 Carmichael

Company Phillips

NORTH Burnett Pool

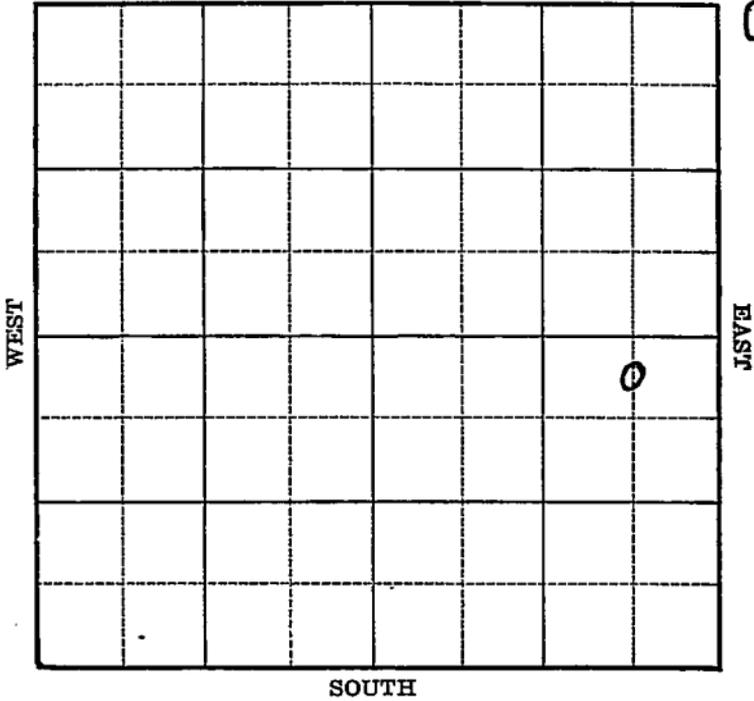

Map No. 71 Sec. 11 Twp. 11 R. 18W

Well No. 2 Carmichael

Phillips Company

FIRST REPORT Contractor

C N L N E S E

330 Ft. from N. Line

_____ Ft. from S. Line

660 Ft. from E. Line

_____ Ft. from W. Line

Burnett Pool

SECTION PLAT

			3

Location _____

Rig up _____

Drilling and Remarks:
Rotary

RECORD

Cased _____ in., _____ ft.

Sand _____

Gas _____

Oil _____

Total Depth _____

PRODUCTION

1st 24 hrs. Nat. _____

1st 24 hrs. after shot _____

Gas _____ Cu. Ft.

Dry Hole _____

Abandoned _____

Date

1 2 1941 19

S. J. LEWIS Scout

Map No. 71 Sec. 11 Twp. 11 R. 18WWell No. 2 Carmichael

Phillips

Company

COMPLETED

Contractor

SECTION PLAT

C W L N E S E

330 Ft. from N. Line

_____ Ft. from S. Line

660 Ft. from E. Line

_____ Ft. from W. Line

BURNETT POOL

			o

Location _____

Rig up _____

Drilling and Remarks:

*Cor. to 3872**5" @ 3378**Echo P. 55163**Map 3000**32 @ Gr*

RECORD

Cased _____ in., _____ ft.

Sand _____

Gas _____

Oil _____

Total Depth 3872 1/2

PRODUCTION

1st 24 hrs. Nat. _____

1st 24 hrs. after shot _____

Gas _____ Cu. Ft.

Dry Hole _____

Abandoned _____

Date

APR 9 1941 19S. J. LEWIS

Scout