KANSAS


Ellis

FORM 51 5M 4-41 PETROL

Section 11 Township 11 Range 18-W

Well No. #4 Carmichael

Company Phillips

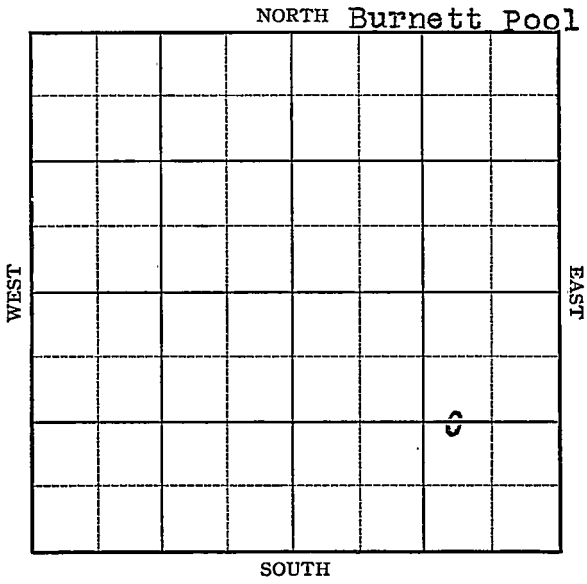

FORM 252-A 5M 1-41 PETROL KANSAS Ellis

Sec. 11 Twp. 11 R. 18-W

Well No. #4 Carmichael Farm

Phillips Company


(Burnett)

____ Ft. from N. Line

1320 Ft. from S. Line

990 Ft. from E. Line

____ Ft. from W. Line

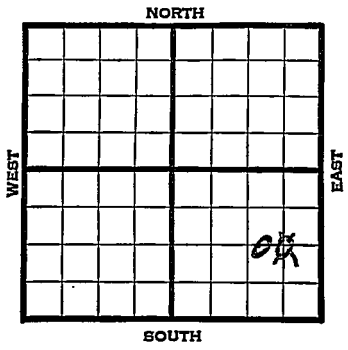

Elev. 1895

1941	REPORT
4/16	Anhy 1155' 8" - 1162'
	T.D. 1168' WOC.
4/24	Drlg. 2730'
5/1	Arb. 3399-3401' T.D. 5" - 3399'
	RUST.
5/7	Arb. 3399'
	5" - 3399'
	T.D. 3403'
	Echometer potential 21,791 bbls.
	Maximum 3000 bbls.
	32. Gravity.
	COMPLETED

Form 26—200 Bks.—1-40—Palace Ellis **KANSAS**

Map No. 71 Sec. 11 Twp. 11 R. 18W


Well No. 4 Carmichael

Phillips Company

Contractor

FIRST REPORT

SECTION PLAT

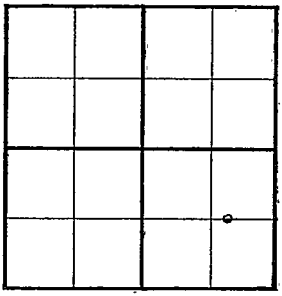

C W½ E½ SE

Ft. from N. Line

1320 Ft. from S. Line

990 Ft. from E. Line

Ft. from W. Line

Burnett pool

Location

Rig up

Drilling and Remarks:

Anhy. 1155
T.D. 1168
8" - 1162
WOC

RECORD

Cased in., ft.

Sand

Gas

Oil

Total Depth

PRODUCTION

1st 24 hrs. Nat.

1st 24 hrs. after shot

Gas Cu. Ft.

Dry Hole

Abandoned

Date

APR 16 1941 19 S. J. LEWIS Scout

Form 26—200 Bks.—1-40—Palace Ellis KANSAS

Map No. 71 Sec. 11 Twp. 11 R. 18W

Well No. 4 Carmichael

Phillips Petroleum Company

COMPLETED Contractor

C W½ E½ SE

_____ Ft. from N. Line


1320 Ft. from S. Line

990 Ft. from E. Line

_____ Ft. from W. Line

BURNETT POOL

SECTION PLAT

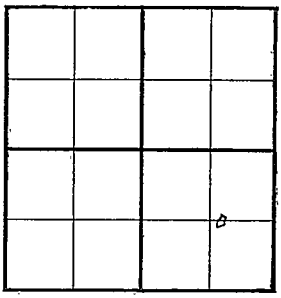

Location _____

Rig up _____

Drilling and Remarks:

Cas & 3399

5" @ 3399

Echo Bt 2179

Alt 3000

32° Gr

RECORD

Cased _____ in., _____ ft.

Sand _____

Gas _____

Oil _____

Total Depth 3403

PRODUCTION

1st 24 hrs. Nat. _____

1st 24 hrs. after shot _____

Gas _____ Cu. Ft.

Dry Hole _____

Abandoned _____

Date

MAY 7 1941 19____

S. J. LEWIS Scout