


FORM 51 5M 4-41 PETROL **KANSAS**

Section 11 Township 11 Range 18-W

Well No. #2 Gamichael

Company R. G. Berry
(Burnett)

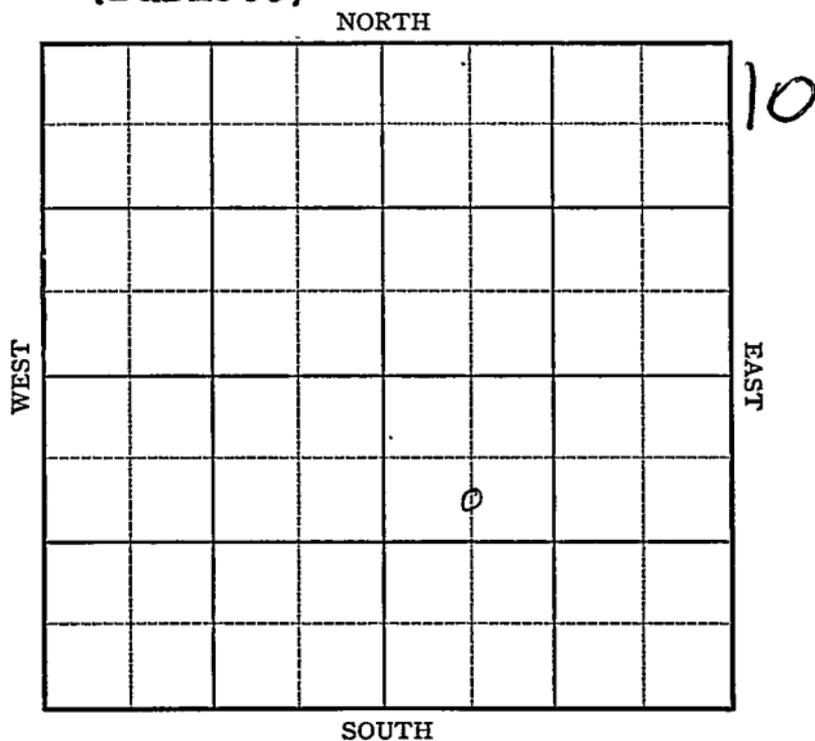

Sec. 11 Twp. 11 R. 18-W

Well No. #2 Carmichael Farm
R. G. Berry Company

(Burnett)


990 Ft. from N. Line

_____ Ft. from S. Line

_____ Ft. from E. Line

660 Ft. from W. Line

Elev. 1926

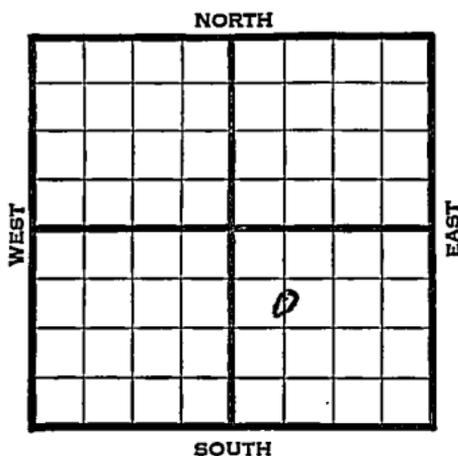

1941	REPORT
7/23	Rotary
7/31	Anhy 1210 8" @ 1210'
	Drlg. 1995'
8/7	Lansing 3070. Drlg. 3165'
8/15	Simpson. Dolo. 3420'
	Arb. 3438
	5" - 3438
	T.D. 3439 SO
	RUST
8/20	Arb. 3438'
	5" - 3438'
	T.D. 3442½'
	Echometer potential 92,447 bbls.
	Maximum 3000 bbls.
	32. Gravity
	COMPLETED

Map No. 71 Sec. 11 Twp. 11 R. 18W

Well No. 2 Carmichael

R. G. Berry Company

FIRST REPORT Contractor

SECTION PLAT

C S L NW SE

990 Ft. from N. Line

_____ Ft. from S. Line

_____ Ft. from E. Line

660 Ft. from W. Line

BURNETT POOL

Location _____

Rig up _____

Drilling and Remarks:

Rotary

RECORD

Cased _____ in., _____ ft.

Sand _____

Gas _____

Oil _____

Total Depth _____

PRODUCTION

1st 24 hrs. Nat. _____

1st 24 hrs. after shot _____

Gas _____ Cu. Ft.

Dry Hole _____

Abandoned _____

Date

JUL 23 1941 19

S I LEWIS Scout

Map No. 71 Sec. 11 Twp. 11 R. 18W

Well No. 2 Carmichael

R. G. Berry Company

COMPLETED Contractor

SECTION PLAT

C S L NW SE

990 Ft. from N. Line

_____ Ft. from S. Line

_____ Ft. from E. Line

660 Ft. from W. Line

BURNETT POOL

Location _____

Rig up _____

Drilling and Remarks:

Cur 3438.
5" @ 3438.
Ec wd P 92447
Max 3000
320 Gr.

RECORD

Cased _____ in., _____ ft.

Sand _____

Gas _____

Oil _____

Total Depth 3442 1/2

PRODUCTION

1st 24 hrs. Nat. _____

1st 24 hrs. after shot _____

Gas _____ Cu. Ft.

Dry Hole _____

Abandoned _____

Date

AUG 20 1941

S. J. LEWIS Scout