


KANSAS

Section 11 Township 11 Range 18W

Well No. #1 Feldkamp "C"

Company B. & R. Drlg.
B. & R. Drlg. Con.

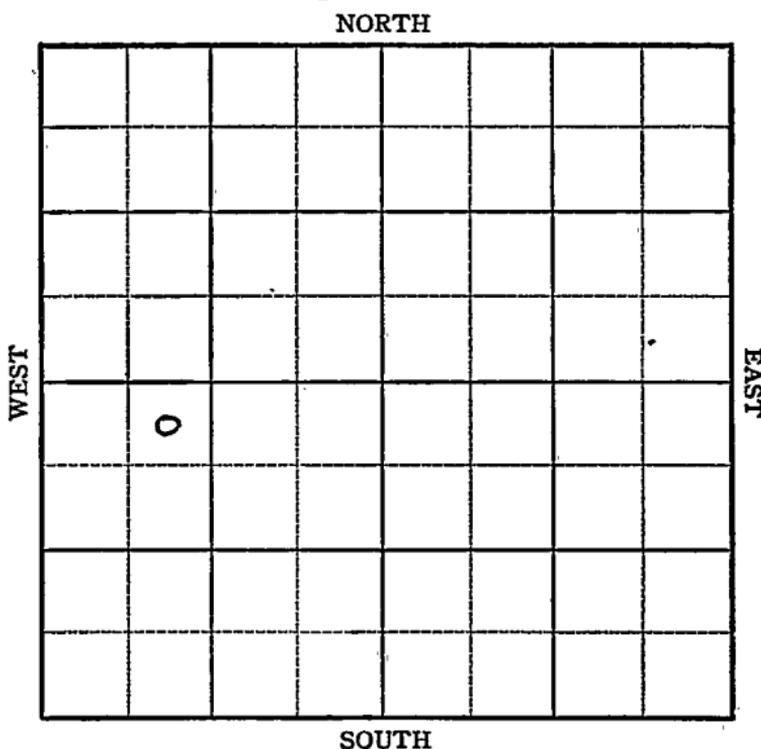

12

Ellis

KANSAS

Sec. 11 Twp. 11 R. 18W

Well No. #1 Feldkamp "C" Farm _____

B & R Drlg. Company _____

Burnett (B & R Drlg., Cont.)
Pool


330' Ft. from N. Line

_____ Ft. from S. Line

_____ Ft. from E. Line

990' Ft. from W. Line

NE NW SW

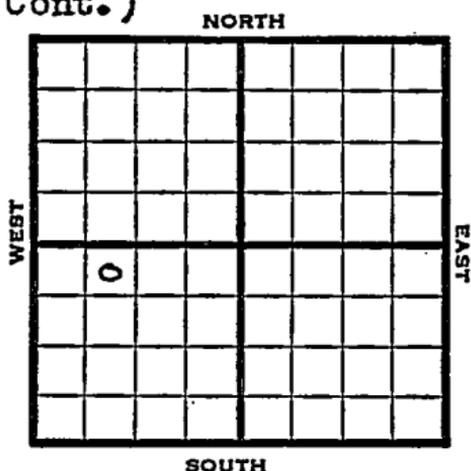

1949

Elev 1959'

R E P O R T

8/17

8" @ 227'

Anhy 1268'

Drlg. 1365'

8/24

Drlg. 3350'

8/31

TD 3600'

Lansing 3209'

Arb. 3556'

Aband.

ABANDONED

Map No. _____ Sec. 11 Twp. 11 R. 18W

Well No. 1 Feldkamp "C"

B & R Drlg. _____ Company

B & R Drlg. _____ Contractor

NE NW SW

FIRST REPORT
SECTION PLAT

330 Ft. from N. Line

_____ Ft. from S. Line

_____ Ft. from E. Line

990 Ft. from W. Line

Ellis County

RECORD

Location _____

Cased _____ in., _____ ft.

Rig up _____

Sand _____

Drilling and Remarks:

Gas _____

8" @ 227

Oil _____

Anhy 1268

Total Depth _____

drlg. 1365

PRODUCTION

1st 24 hrs. Nat. _____

1st 24 hrs. after shot _____

Gas _____ Cu. Ft.

Dry Hole _____

Abandoned _____

Date

AUG 17 1949 19

S. J. LEWIS Scout

Kansas

Map No. K71 Sec. 11 Twp. 11 R. 18thWell No. I Feldkamp "C"B & R Drlg. Company**ABANDONED**

Contractor

NE NW SW

E. 1959
SECTION PLAT330 Ft. from N. Line Ft. from S. Line Ft. from E. Line-990 Ft. from W. Line

o			

Ellis County

Location _____

Rig up _____

Drilling and Remarks:

Lease 3209Ac 48356

RECORD

Cased _____ in., _____ ft.

Sand _____

Gas _____

Oil _____

Total Depth 3610

PRODUCTION

1st 24 hrs. Nat. _____

1st 24 hrs. after shot _____

Gas _____ Cu. Ft.

Dry Hole _____

Abandoned _____

Date

AUG 31 1949 19S. J. LEWIS Scout