

Ellis

KANSAS

Section 11 Township 11 Range 18WWell No. #1 FeldkempCompany Ash-Mar & NCRA

NORTH

WEST

EAST

SOUTH

14

0

Sec. 11 Twp. 11 R. 18.WWell No. # 1 Feldkamp FarmAsh-Mar & NCRA

Company

Contractor

Ft. from N. Line

990


Ft. from S. Line

330

Ft. from E. Line

Ft. from W. Line

NE SE SW

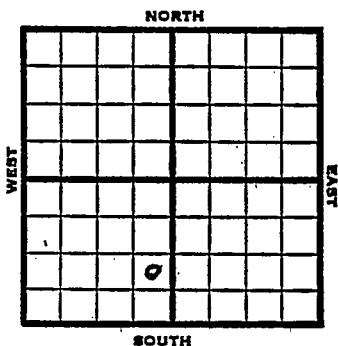

1953 Elev 1888' REPORT

2/4	Spud 1-28-53 8" @ 240 Drlg. 2200'
2/12	Top 2866' Heeb 3087' Tor 3109' Lans. 3131' Drlg. 3365'
2/19	Cong 3376' Simp 3426 Arb. 3442' DST 3430-47, 2 hrs, 2100' oil, 845# RTD 3447' 5" @ 3442
2/26	P/15 BOPH
3/12	NR
3/19	NR
3/26	NR
4/2	"
4/9	"
4/16	NR
4/23	NR
4/30	"
5/7	NR
5/21	"
5/28	"
6/3	"

OVER

1953

#1 Feldkamp

6/17 Spud 1-28-53

Oil Well

TD 3447'

8" @ 240'

Top. 2866, Heeb 3087,

8" @ 240'

Top. 2866, Heeb 3087, Tor 3109, Lans
3131, Cong 3376, Simp 3426, Arb 3442,

DST 3430-47 opn 2 hr, FU 2100' oil

845#

TD 3447'

5" @ 3442'

GO to 3447' FU 2100' oil 5 hr.

S/ 12 boph 3 hr. S/ 15 boph 6 hr.

Comp. 50 bopd 81% wtr.

COMPLETED

County **Ellis** State **Kansas**

Sec. **11** (Blk. **11** (Sur. **18W** Map No.

Operator Ash-Mar & NCRA

Well No. 1 Farm Feldkamp

Elev.	Location	NE	SE	SW
-------	----------	----	----	----

FIRST REPORT

990 Ft. From S Line SW

330 Ft. From E Line Quarter

1st. Report FEB 4 1953

Completion

Remarks

Spudding Date **1-28-53**

Drig. Data


8ⁿ @ 240 drlg. 2200

200 440

Post Cards	<i>mm</i>
Large Small Map	
Large Wall Map	<i>B</i>
Travelling	
Misc.	

FEB 6 1953

Orig. Date

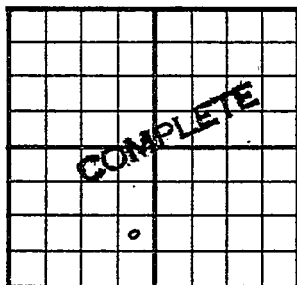County Ellis State KansasSec. 11 (Blk. Twp.) 11 (Sur. Rge.) 18W Map No.Operator Ash-Mar & NCRAWell No. 1 Farm FeldkampElev. 1888 Location NE SE SW990 Ft. From S Line SW330 Ft. From E Line Quarter

1st. Report _____

Completion JUN 17 1953

Remarks _____

Spudding Date 1-28-53Drlg. Data Oil well TD 34478" @ 240 Top. 2866 Heeb. 3087Tor. 3109 Lans. 3131 Cong. 3376Simp. 3426 Arb. 3442 DST 3430-47open 2 hr. FU 2100' oil 845# TD 34475" @ 3442 CO to 3447 FU 2100' oil5 hr. S/ 12 boph 3 hr. S/ 15 boph 6 hr.Comp. 50 bopd 81% wtr.

J. G. McGEHEE

JUN 27 1952

Scout Cards

Orig. Data