


SECTION 11 TOWNSHIP 11S RANGE 21W

WELL NO. #2 William Walz

COMPANY Pan American

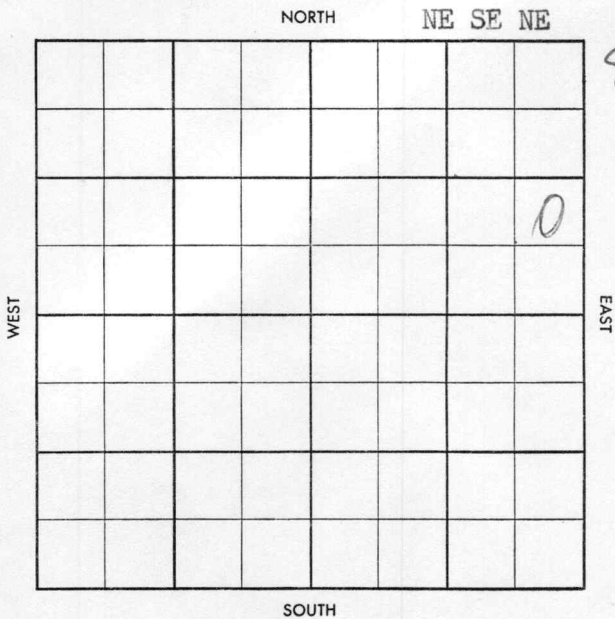

5

County Trego Elev. _____
 Sec. 11 Twp. 11 Rge. 21W
 Company Pan American
 Farm Name William Walz No. 2

Co.

TOPS	DEPTH	LOG	DATUM
Anh.			
Tp.			
H.			
Tr.			
Dg.			
Bl.			
L.			
K.C.			
B.K.C.			
Ce.			
C.			
M.			
M.			
K.			
Mz.			
Mq.			
V.			
S.			
S.			
A.			
R.			
Pe.			
G.			
T.D.			

Loc. in Sec.

NE SE NE

Geol.

Contr.

Lewis Dolg

Pool

Walz

SEP 18 37		
FIRST REPORT		

Lse.

No.

Sec.

T.

R.

Date Comm.

Location

County Trego Elev. 2150
 Sec. 11 Twp. 11 Rge. 21W
 Company Pan American
 Farm Name William Walz No. 2

TOPS	DEPTH	LOG	DATUM
Anh.			
TP.			
H.	3400		
Tr.			
Dg.			
Bl.			
L.	3440		
K.C.			
B.K.C.			
Ce.			
C.			
M.			
M.			
K.			
Mz.			
Ma.			
V.			
S.			
S.	3759		
A.			
R.			
PE.			
G.			
T.D.	3800		

Loc. in Sec. NE SE NE

Geol. _____

Contr. _____

Lewis Drlg.

Pool _____

Walz

OCT 9 '57

ABANDONED

Date Comm. _____

Location SEP 25 '57 9-23-57 85" 209/150

WOC OCT 2 '57 3755 OCT 9 '57

DST 3727-55 60" 14' M

NS BHP 40-30/30" DST 3756-64

60" 10' M NS BHP 0 run log

D & A