


Section 11 Township 11 Range 21 W

Well No. # 1 Walz "A"

Company Continental Oil

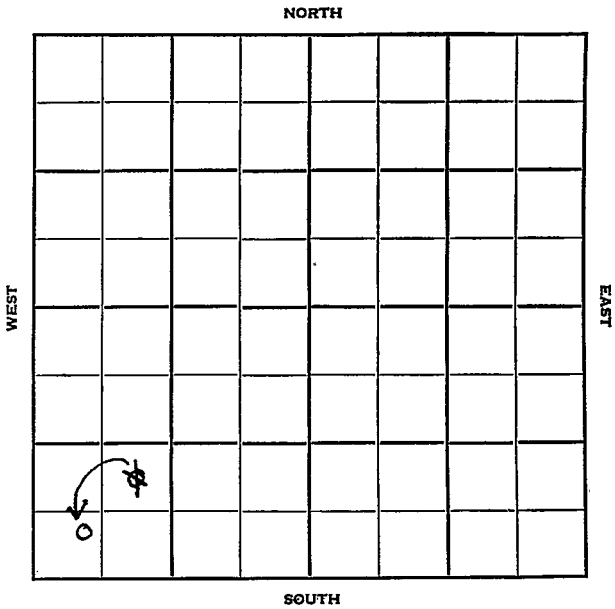

Trego

KANSAS

Sec. 11 Twp. 11 R. 21 W

Well No. # 1 Walz (A) Farm

Continental Company

Anschultz Contractor

Walz

Ft. from N. Line

440

Ft. from S. Line

990


Ft. from E. Line

446

Ft. from W. Line

990

SW
NE SW SW

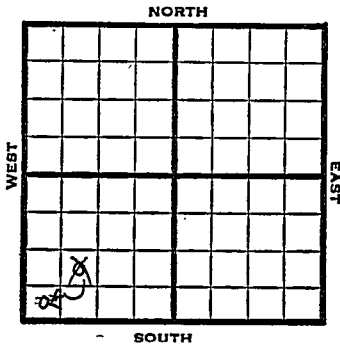

1951

Elev. 2179' REPORT

9/19

Location

10/24

Spud 9-18-51

D&A TD 3936'

10" @ 217

Anhy 2168 Heeb. 3436

Lans. 3479 Arb. 3869-3936 TD

D&A

ABANDONED

Map No. _____ Sec. 11 Twp. 11 R. 21W

Well No. 1 Walz "A"

Continental Oil Company

CONFECTION Contractor

SW SW SW

SECTION PLAT

_____ Ft. from N. Line

440 Ft. from S. Line

_____ Ft. from E. Line

440 Ft. from W. Line

Trego County

Location _____

Rig up _____

Drilling and Remarks: _____

Reported _____

NE SW SW

RECORD

Cased _____ in., _____ ft.

Sand _____

Gas _____

Oil _____

Total Depth _____

PRODUCTION

1st 24 hrs. Nat. _____

1st 24 hrs. after shot _____

Gas _____ Cu. Ft.

Dry Hole _____

Abandoned _____

Date

SEP 26 1951

J. E. TVPA

19

Scout

