

Trego

FORM 51 IOM 12-46 PETROL


KANSAS

Section 11 Township 11 Range 22W

Well No. 55 Strat Hillman

Company Continental et al

Wildcat. NORTH

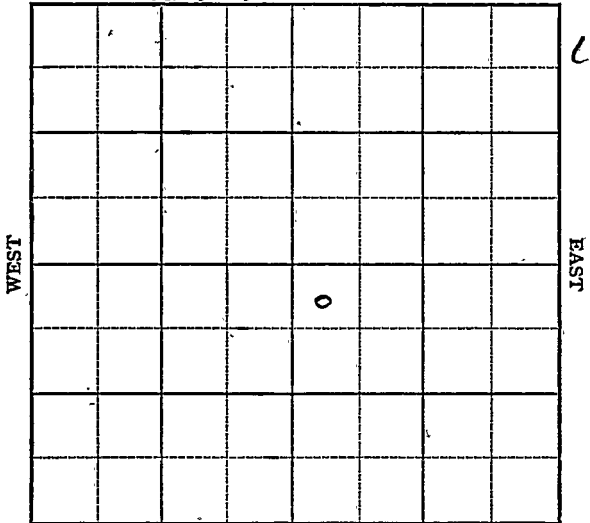

KANSAS

Trego

Sec. 11 Twp. 11 R. 22W

Well No. 55 Strat Hillman Farm

Continental etal Company

Wildcat


330 Ft. from N. Line

Ft. from S. Line

Ft. from E. Line

330 Ft. from W. Line

NW SE

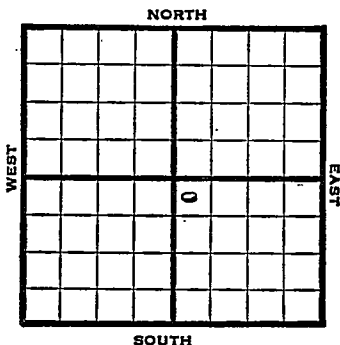

1947 Elev. 2141' REPORT

4/30 Drlg. 2502'

5/7 Drlg. 3771'

5/14 Arb. 3854'
TD 3904'

ABANDONED

Map No. 69 Sec. 11 Twp. 11 R. 22W

Well No. 55 Strat Hillman

Continental etall Company

FIRST REPORT

Contractor

NW SE


SECTION PLAT

330 Ft. from N. Line

 Ft. from S. Line

 Ft. from E. Line

330 Ft. from W. Line

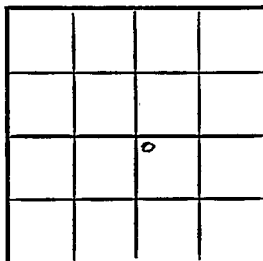

Trego County

Location

Rig up

Drilling and Remarks:

drlg. 2502

RECORD

Cased in., ft.

Sand

Gas

Oil

Total Depth

PRODUCTION

1st 24 hrs. Nat.

1st 24 hrs. after shot

Gas Cu. Ft.

Dry Hole

Abandoned

Date

APR 30 1947 19

S. J. LEWIS Scout

Kansas

Wildcat

Map No. k 69 Sec. 11 Twp. 11 R. 22WWell No. #1 Hillman #55 StratContinental etal. Company**ABANDONED**

Contractor

E. J. 2141

NW SE

SECTION PLAT

330 Ft. from N. Line Ft. from S. Line Ft. from E. Line330 Ft. from W. LineTrego CountyLocation Rig up

Drilling and Remarks:

Per 3854**RECORD**Cased in., ft.Sand Gas Oil Total Depth 3814**PRODUCTION**1st 24 hrs. Nat. 1st 24 hrs. after shot Gas Cu. Ft.Dry Hole Abandoned

Date

MAY 14 194719S. J. LEWISScout