

Grego 230

Map No. KANSAS Sec. 11 Twp. 11 R.

Well No. 2-Heckman Farm
Alma Pet et al Company


_____ Ft. from N. Line

660 Ft. from S. Line

_____ Ft. from E. Line

660 Ft. from W. Line

Elev. 2215

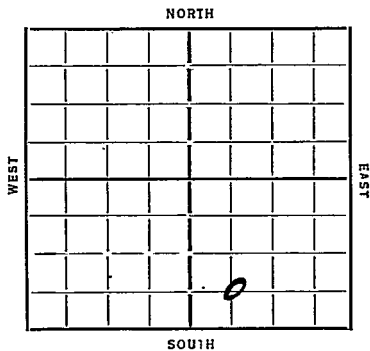

Date 1931 REPORT O. W. D. D.

7/7 Moving
7/11 Rig
7/18 Dlg 75
8/8 K.C. 3458
 Core 3450-60
 Rec some saturation
8/15 Rep Bull wheel
8/22 Pay 3504-10
 Subst 117 gals 7 hrs.
8/29 1000 acid
9/4 K.C. 3458
 Oil 3504-10
 T 7 3510
 1000 acid
 507 gals.

COMPLETED

OVER

O. W. D. D.

1939

12/27

Old T.D. 3510'

Arb. 3940' water.

T.D. 4077'

FIRST REPORT

and

ABANDONED

Map No. 69 Sec. 11 Twp. 11 R. 23W

Well No. 2-Heckman

Alma pet etal Company

Contractor

COMPLETED

SECTION PLAT

Ft. from N. Line
660 Ft. from S. Line
Ft. from E. Line
660 Ft. from W. Line

			0

Location.....

Rig up.....

Drilling and Remarks:
1000 and

507 bbls

RECORD

Cased..... in., ft.

Sand K.C. 3458

Gas.....

Oil 3504-10

Total Depth 3510

PRODUCTION

1st 24 hrs. Nat.....

1st 24 hrs. after shot.....

Gas..... Cu. Ft.

Dry Hole.....

Abandoned.....

Date

9-4-35 192 GENERAL MANUFACTURING Scout

Trego

KANSASMap No. 69 Sec. 11 Twp. 11 R. 23WWell No. 2 HeckmanAlma Petroleum etal

Company

~~FIRST REPORT~~

Contractor

ABANDONED

C SW SE

SECTION PLAT

		o	~

_____ Ft. from N. Line

660 Ft. from S. Line

_____ Ft. from E. Line

660 Ft. from W. Line

WAKEENEY POOL

Location _____

Rig up _____

Drilling and Remarks:

OWDD-OTD 3510

Arb. 3940

Water

RECORD

Cased _____ in., _____ ft.

Sand _____

Gas _____

Oil _____

Total Depth 4077

PRODUCTION

1st 24 hrs. Nat. _____

1st 24 hrs. after shot _____

Gas _____ Cu. Ft.

Dry Hole _____

Abandoned _____

Date

DEC 27 1939 19

S. J. LEWIS Scout