


Section 12 Township 11 Range 19WWell No. #1 ~~Malliecar~~ GasawayCompany Walters Drilg. Co.

NORTH

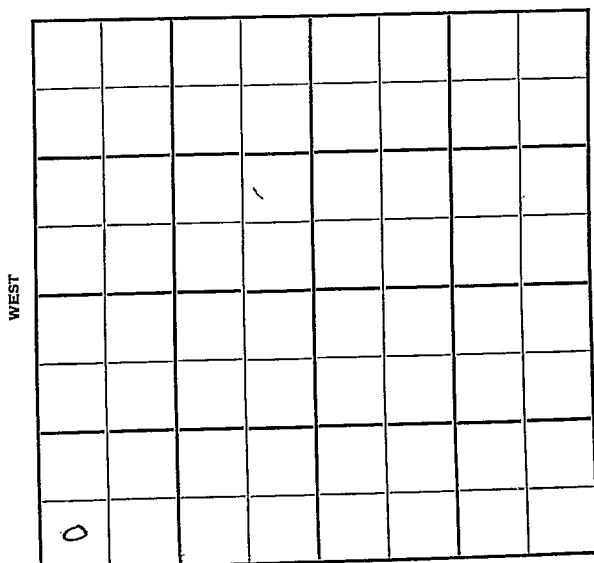

SOUTH

Sec. 12 Twp. 11 R. 19W

#1 Mollicar Gasaway

Well No. Farm

Walters Drlg.

Company

Contractor

Wildcat


Ft. from N. Line

330 Ft. from S. Line

Ft. from E. Line

330 Ft. from W. Line

SW SW SW

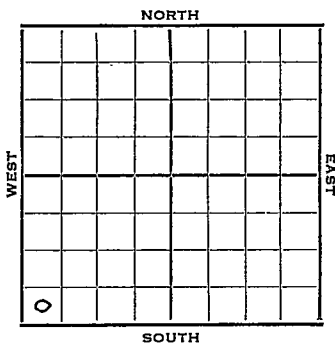

1952 Elev. 1999'

REPORT

5/28 Moving In.

6/11 Drlg. 2410'

6/18 Spud 6-5-52

D&A TD 3590 8" @ 226'

Anhy 1345 Top. 2989

Heeb. 3212 Lans. 3252

DST 3409-51 open 3/4 hr. rec. 25' mud

B KC 3480

DST 3500-3521 open 50 min. rec. 4' mud

Cong. 3509


DST 3538-78 open 1 hr. rec. 40' ocm

Simp. 3528 Arb. 3569

TD 3590' DST 3578-90 open 1/2 hr.

rec. 30' muddy oil D&A

ABANDONED

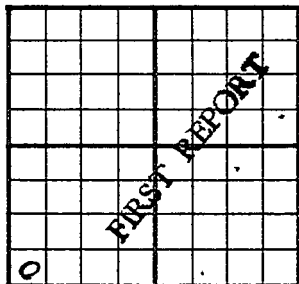County **Ellis** State **Kansas**Sec. **12** (Blk.) **11** (Sur.) **19W** Map No.Operator **Walters Drilling Co.**Well No. **1** Farm / **Mollicar**Elev. Location **SW SW SW****330** Ft. From **S** Line **SW****330** Ft. From **W** Line Quarter1st. Report **MAY 28 1952**

Completion

Remarks

Walters - Contr.

Spudding Date

Drlg. Data


Wildcat**MI****J. G. McGENEE**

County Ellis State Kansas
 Sec. 12 (Blk.) 11 (Sur.) 19W Map No.

Operator Walters Drilling Co.

Well No. 1 Farm Mallicar Lasaway

Elev. 1999 Location SW SW SW

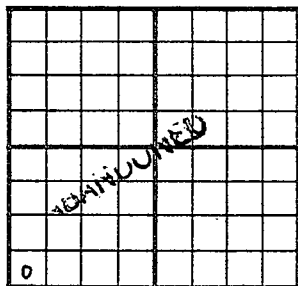

330 Ft. From S Line SW

330 Ft. From W Line Quarter

1st. Report

Completion JUN 18 1952

Remarks Wildcat

Walters - Contr.

Spudding Date 6-5-52

Drlg. Data D & A TD 3590

8" @ 226 Anhy 1345 Top. 2989

Heeb. 3212 Lans. 3252 DST 3409-51

open 3/4 hr. Rec. 25' mud B KC 3480

DST 3500-3521 open 50 min. Rec. 4' mud

Cong. 3509 DST 3538-78 open 1 hr.

Rec. 40' ocm Simp. 3528 Arb. 3569

TD 3590 DST 3578-90 open 1/2 hr.

Rec. 30' muddy oil

D & A-

J. G. McGEHEE