

7: 220
Ellis

Form 51-5M-11-38-Palace

KANSAS

Section 12 Township 11 Range 18-W

Well No. #1 ~~L. Beyer~~ Ridler "A"

Company Bay Petroleum

So. Burnett Pool

NORTH

							0

WEST

EAST

SOUTH

8

Sec. 12 Twp. 11 R. 18-W

Well No. #1 ~~I. Boyer~~ Ridler "A" Farm

Bay Petr. Company
(South Burnett)


_____ Ft. from N. Line

330 Ft. from S. Line

330 Ft. from E. Line

_____ Ft. from W. Line

Elev. 1874

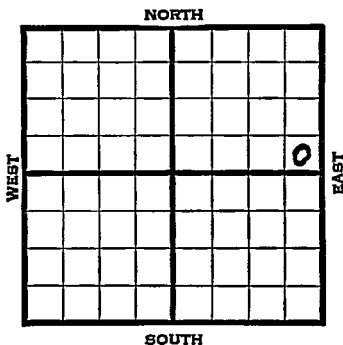

1939	REPORT
6/21	Cellar.
6/29	Rotary.
7/6	Rigging up.
7/13	" "
7/20	15" - 117' 10" - 1114'
	Anhy 1114' Drig. 2490'
7/26	Simp. 3346' Arb. 3365'
	Run pipe.
8/3	7" - 3366' T.D. 3369'
	2800' oil. 5000 acid. Testing.
8/10	No test.
8/17	" " "
8/23	Arb. 3365'
	7" - 3366'
	500 acid.
	T.D. 3369'
	Depthograph potential 44,000
	Maximum 3500 bbls.
	COMPLETED

Map No. 71 Sec. 12 Twp. 11 R. 18W

Well No. 1 L. Boyer

Bay Petroleum Company

Contractor

FIRST REPORT

SE NE

SECTION PLAT

			o

 Ft. from N. Line

330 Ft. from S. Line

330 Ft. from E. Line

 Ft. from W. Line

SOUTH BURNETT POOL

Location

Rig up

Drilling and Remarks:

Cellar

RECORD

Cased in., ft.

Sand

Gas

Oil

Total Depth

PRODUCTION

1st 24 hrs. Nat.

1st 24 hrs. after shot

Gas Cu. Ft.

Dry Hole

Abandoned

Date

JUN 21 1939

19

S. J. LEWIS

Scout

Map No. 71 Sec. 12 Twp. 11 R. 18W

Well No. 1 Riddler "A"

Bay Petroleum Company

Contractor

BSE

SECTION PLAT

			0

COMPLETED

_____ Ft. from N. Line

330 Ft. from S. Line

330 Ft. from E. Line

_____ Ft. from W. Line

South Burnett Pool

Location _____

Rig up _____

Drilling and Remarks:

Ar & 3365
7" @ 3366
500 acid
Depthograph P.S.
44,000
Maximum 3500

RECORD

Cased _____ in., _____ ft.

Sand _____

Gas _____

Oil _____

Total Depth 3369

PRODUCTION

1st 24 hrs. Nat. _____

1st 24 hrs. after shot _____

Gas _____ Cu. Ft.

Dry Hole _____

Abandoned _____

Date

AUG 23 1939 19

S. J. LEWIS

Scout