

KANSAS


Ellis

Form 51-5M-7-39-Palace

Section 12 Township 11 Range 18-W

Well No. #4 Hadley "A"

Company Darby

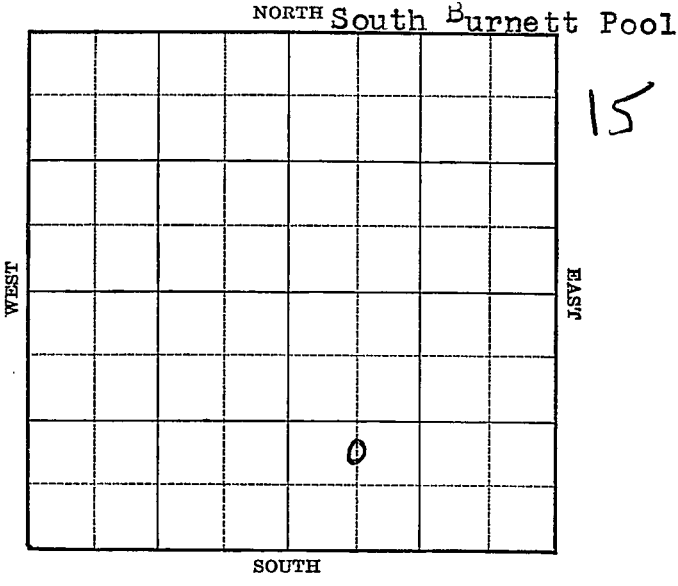

Sec. 12 Twp. 11 R. 18-W

Well No. #4 Hadley "A" Farm

Darby Company

(South Burnett)


 Ft. from N. Line

990 Ft. from S. Line

 Ft. from E. Line

660 Ft. from W. Line

Elv. 1850

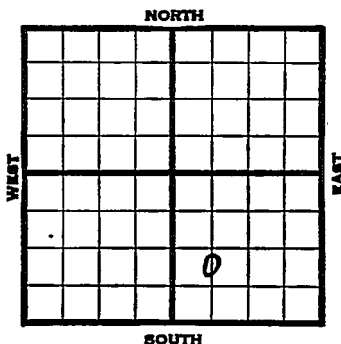

1939	REPORT
12/13	Rotary.
12/21	Surface hole.
12/28	15" - 105' Anhy 1090'
	10" - 1094' Drlg. 3300'
1940	
1/4	Arb. 3334' Drlg.
1/10	Arb. 3334'
	7" - 3334'
	T.D. 3340'
	1000 acid.
	Depthograph potential 85,000 bbl
	Maximum 3000 bbls.
	COMPLETED

Map No. 71 Sec. 12 Twp. 11 R. 18W

Well No. 4 Hadley "A"

Darby

Company

Contractor

**FIRST REPORT
C N L SW SE**

SECTION PLAT

		o	

_____ Ft. from N. Line

990 Ft. from S. Line

_____ Ft. from E. Line

660 Ft. from W. Line

SOUTH BURNETT POOL

Location _____

Rig up _____

Drilling and Remarks:

Rotary

RECORD

Cased _____ in., _____ ft.

Sand _____

Gas _____

Oil _____

Total Depth _____

PRODUCTION

1st 24 hrs. Nat. _____

1st 24 hrs. after shot _____

Gas _____ Cu. Ft.

Dry Hole _____

Abandoned _____

Date

DEC 13 1939

S. I. LEWIS Scout

Map No. 71 Sec. 12 Twp. 11 R. 18WWell No. 4 Hadley "A"Darby Company

Contractor

~~COMPLETED~~

C N L SW SE

 Ft. from N. Line990 Ft. from S. Line Ft. from E. Line660 Ft. from W. Line

SECTION PLAT

		0	

SOUTH BURNETT POOL

Location Rig up

Drilling and Remarks:

*Cor 3334**7" @ 3334**1000 Acid**Geographic Plat.**5300**McFinnigan 3000*

RECORD

Cased in.; ft.Sand Gas Oil Total Depth 3340

PRODUCTION

1st 24 hrs. Nat. 1st 24 hrs. after shot Gas Cu. Ft.Dry Hole Abandoned

Date

JAN 10 1940 19

S. J. LEWIS Scout