

KANSAS

Form 51-5M-7-39-Palace

Ellis

Section 12 Township 11 Range 18-W

Well No. #5 Hadley "A"

Company Darby

NORTH So. Burnett Pool

						0	

SOUTH

16

WEST

EAST

KANSAS

Ellis

Sec. 12 Twp. 11 R. 18-WWell No. #5 Hadley "A" FarmDarby

Company

(South Burnett)

Ft. from N. Line


990

Ft. from S. Line

990

Ft. from E. Line

Ft. from W. Line

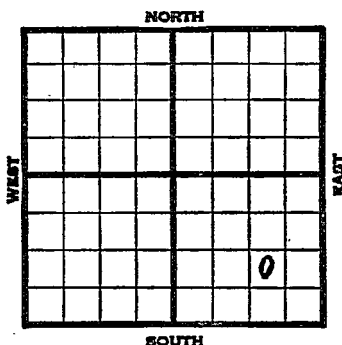

Elev. 1851

1940	REPORT
1/10	Location
1/18	Rotary.
1/25	"
2/1	13" - 112' Anhy 1071'
	8" - 1080' Drlg. 1170'
2/8	Lans. 3048' 5" - 3230' RUST.
	Will perforate.
2/15	12 shots 3089-92'
	700' water. S.S.O.
2/23	48 shots 3082-85' 4000 acid.
	Pump 128 bbls. 8 hours.
	Cut 9.2%
2/29	Shut down.
3/8	" "
3/14	12 shots 3057-60'
	12 shots 3054-57' SSO & W.
3/21	Shut down.
3/28	" "
	OVER

1940
4/3

Lans. 3048'
5" - 3230'
T.D. ~~3082~~ 3230'
48 shots 3082-85'
4000 acid.
24 shots 3054-60'
12 " 3129-32'
12 " 3132-34'
12 " 3134-36'
1/3 B.W. S.S.O.

ABANDONED

Map No. 71 Sec. 12 Twp. 11 R. 18WWell No. 5 Hadley "A"Darby

Company

Contractor

FIRST REPORT
NW SE SE

Ft. from N. Line

990 Ft. from S. Line

990 Ft. from E. Line

Ft. from W. Line

SECTION PLAT

			o

SOUTH BURNETT POOL

Location X

Rig up

Drilling and Remarks:

RECORD

Cased _____ in., _____ ft.

Sand _____

Gas _____

Oil _____

Total Depth _____

PRODUCTION

1st 24 hrs. Nat. _____

1st 24 hrs. after shot _____

Gas _____ Cu. Ft.

Dry Hole _____

Abandoned _____

Date

JAN 10 1940

19

S. J. LEWIS

Scout

Misc Small Maps	<i>Handwritten signature</i>
Cards	<i>Handwritten signature</i>
Tracing	<i>Handwritten signature</i>
France Map	<i>Handwritten signature</i>
Scarborough Map	<i>Handwritten signature</i>
Moody Map	<i>Handwritten signature</i>
Geological Dept.	
Moody Flat Book	

Map No. 71 Sec. 12 Twp. 11 R. 18WWell No. 5 Hadley "A"Darby Petroleum Company~~ABANDONED~~

Contractor

ABANDONED

NW SE SE

SECTION PLAT

			o

 Ft. from N. Line990 Ft. from S. Line990 Ft. from E. Line Ft. from W. Line

SOUTH BURNETT POOL

Location Rig up

Drilling and Remarks:

Lans. 30485" @ 3230 TD48shots 3082-854000 acid24shots 3054-6012 " 3129-3212 " 3132-3412 " 3134-361/3 BW-SSO**RECORD**Cased in., ft.Sand Gas Oil Total Depth 3230**PRODUCTION**1st 24 hrs. Nat. 1st 24 hrs. after shot Gas Cu. Ft.Dry Hole Abandoned

Date

APR 16 1940₁₉S. J. LEWISScout

Misc. Small Maps

Cards

Tracing

France Map

Scarborough Map

Moody Map

Geological Dept.

Moody Flat Book

Map No. 71 Sec. 12 Twp. 11 R. 18 WWell No. 5 Hadley "A"Darby

Company

Contractor

ABANDONED

NW SE SE

Ft. from N. Line

990 Ft. from S. Line990 Ft. from E. Line

Ft. from W. Line

SECTION PLAT

			o

SOUTH BURNETT POOL

Location _____

Rig up _____

Drilling and Remarks:

*Leve. 3048**5" @ 3230**48 Skt to 3072-85**4008 acid**24 Skt to 3054-60**12 " 3129-32**12 " 3132-34**12 " 3134 36**1/3 AN. S.S.D.*

Date

RECORD

Cased _____ in., _____ ft.

Sand _____

Gas _____

Oil _____

Total Depth 3092.

PRODUCTION

1st 24 hrs. Nat. _____

1st 24 hrs. after shot _____

Gas _____ Cu. Ft.

Dry Hole _____

Abandoned _____

APR 3 1940 19

S. J. LEWIS Scout

Sam: Please have scout check
the total depth of this well. *Members*

Pittman

Sandy: 5ⁿ 3230 TD 3092. Please check

Misc Small Maps	<i>BM</i>
Cards	<i>BM</i>
Tracing	<i>BM</i>
France Map	<i>BM</i>
Scarborough Map	<i>BM</i>
Moody Map	
Geological Dept.	
Moody Flat Book	