

KANSAS


Ellis

Form 51-5M-7-39-Palace

Section 12 Township 11 Range 18-W

Well No. #2 Sites

Company Phillips

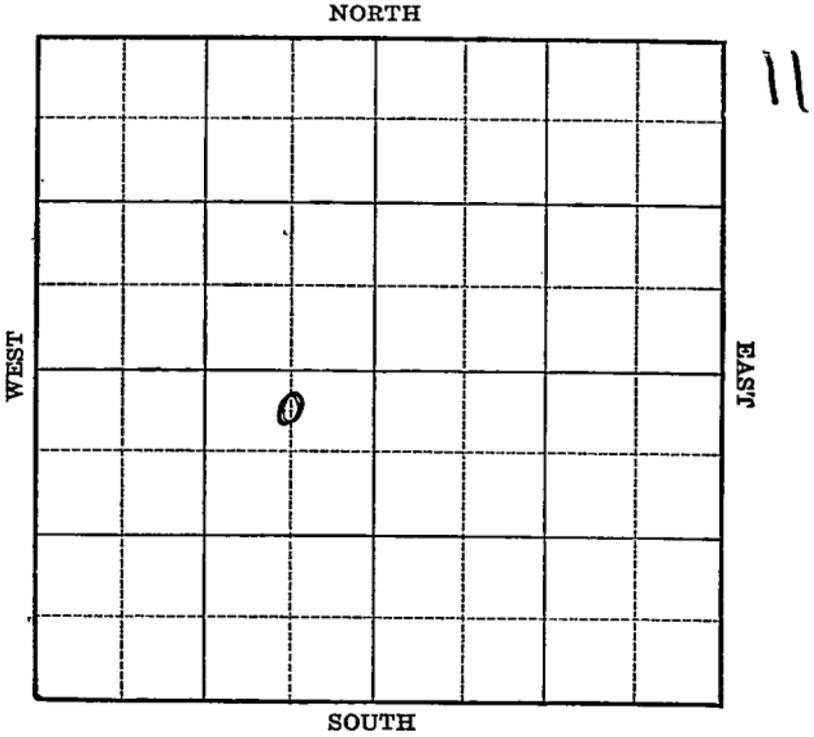

Sec. 12 Twp. 11 R. 18-W

Well No. #2 Sites Farm

Phillips Company

(South Burnett)


330 Ft. from N. Line

Ft. from S. Line

660 Ft. from E. Line

Ft. from W. Line

Elv. 1860

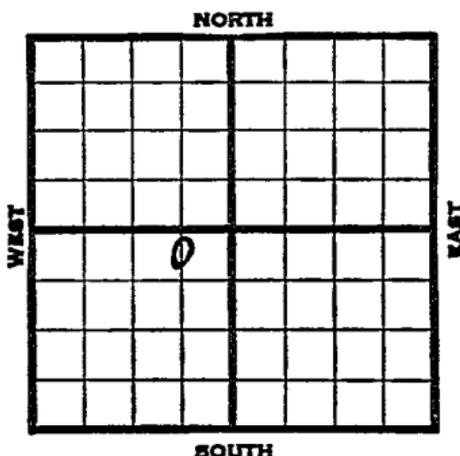

1939	REPORT
12/6	13" - 86'
	TD 102' WOC.
12/14	Anhy 1105' 8" - 1112'
	Drlg. 1842'
12/21	Lans. 3044' Drlg. 3058'
12/28	Arb. 3352' 5" - 3352'
	T.D. 3354' SO RUST.
1940	
1/4	" " " "
1/11	T.D. 3356' Swab 59 bbls. oil in 4 hrs 2100' off bottom.
1/17	Arb. 3352'
	5" - 3352'
	T.D. 3356'
	3000 acid.
	Echometer potential 7409 bbls.
	Maximum 3000 bbls.
	COMPLETED

Map No. 71 Sec. 12 Twp. 11 R. 18WWell No. 2 SitesPhillips

Company

Contractor

FIRST REPORTC $N\frac{1}{2}$ NE SW330 Ft. from N. Line Ft. from S. Line660 Ft. from E. Line Ft. from W. Line**SECTION PLAT**

	o		

SOUTH BURNETT POOLLocation Rig up

Drilling and Remarks:

13" - 86102 TD - WOC**RECORD**Cased in., ft.Sand Gas Oil Total Depth **PRODUCTION**1st 24 hrs. Nat. 1st 24 hrs. after shot Gas Cu. Ft.Dry Hole Abandoned

Date

DEC 6 1939 19S. J. LEWIS Scout

Map No. 71 Sec. 12 Twp. 11 R. 18W

Well No. 2 Sites

Phillips Company

Contractor

COMPLETED

C $N\frac{1}{2}$ NE SW

330 Ft. from N. Line

_____ Ft. from S. Line

660 Ft. from E. Line

_____ Ft. from W. Line

SECTION PLAT

	o		

SOUTH BURNETT POOL

Location _____

Rig up _____

Drilling and Remarks:

Cut 3352

5" C 3352

3000 acid

Echometer Pat

7409

Maximum 3000

RECORD

Cased _____ in., _____ ft.

Sand _____

Gas _____

Oil _____

Total Depth 3356

PRODUCTION

1st 24 hrs. Nat. _____

1st 24 hrs. after shot _____

Gas _____ Cu. Ft.

Dry Hole _____

Abandoned _____

Date

JAN 17 1940 19

S. J. LEWIS Scout