KANSAS

Form 51-5M—7-39—Palace

Ellis

Section 12 Township 11 Range 18-W

Well No. #5 Sites

Company Phillips

South Burnett Pool

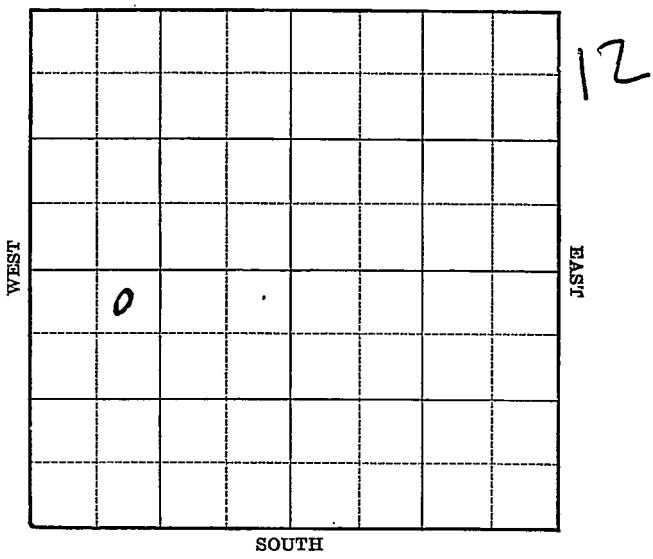

KANSAS Ellis

FORM 252-A 5M 2-40

Sec. 12 Twp. 11 R. 18-W

Well No. #5 Sites Farm

Phillips Company

(South Burnett)

330 Ft. from N. Line

Ft. from S. Line

Ft. from E. Line

990 Ft. from W. Line

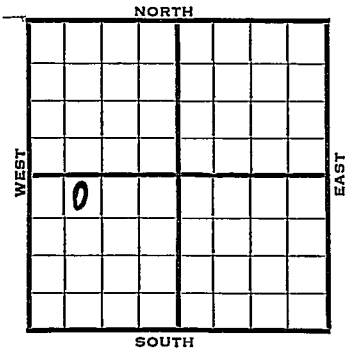

Elev. 1865

1940	REPORT
5/22	Location
5/29	Cellar.
6/5	13" - 58' Anhy 1114'
	8" - 1128' Drlg. 1200'
6/13	Lans. 3056' Drlg. 3196'
6/20	Arb. 3357½'-61' T.D. 5" - 3357½'
	RUST.
6/27	"
7/3	"
7/11	T.D. 3364½' 2950' oil.
7/17	Arb. 3357½'
	5" - 3357½'
	T.D. 3364½'
	Echometer potential 5756 bbls.
	Maximum 3000 bbls.
	COMPLETED

Form 26—200 Bks.—1-40—Palace Ellis KANSAS

Map No. 71 Sec. 12 Twp. 11 R. 18W

Well No. 5 Sites

Phillips Company

Contractor

FIRST REPORT

NE NW SW

330 Ft. from N. Line

Ft. from S. Line

Ft. from E. Line

990 Ft. from W. Line

SOUTH BURNETT POOL

SECTION PLAT

Location X

Rig up

Drilling and Remarks:

RECORD

Cased in., ft.

Sand

Gas

Oil

Total Depth

PRODUCTION

1st 24 hrs. Nat.

1st 24 hrs. after shot

Gas Cu. Ft.

Dry Hole

Abandoned

Date

MAY 22 1940 19

S. J. LEWIS Scout

Form 26—200 Bks.—1-40—Palace Ellis KANSAS

Map No. _____ Sec. 12 Twp. 11 R. 18W

Well No. 5 Sites

Phillips Company

Contractor

COMPLETED

NE NW SW

330 Ft. from N. Line

Ft. from S. Line

Ft. from E. Line

990 Ft. from W. Line

SOUTH BURNETT POOL

SECTION PLAT

Location _____

Rig up _____

Drilling and Remarks:

Ar & 3357½

5" @ 3357½

Ec hometer Pat

5756

Mar 3005

RECORD

Cased _____ in., _____ ft.

Sand _____

Gas _____

Oil _____

Total Depth 3364½

PRODUCTION

1st 24 hrs. Nat. _____

1st 24 hrs. after shot _____

Gas _____ Cu. Ft.

Dry Hole _____

Abandoned _____

Date

JUL 17 1940 19

S. J. LEWIS Scout