

# KANSAS

Ellis


Form 51-5M-7-40-Palace

Section 12 Township 11 Range 18-W

Well No. 7 Sites

Company Phillips

NORTH Brunett Pool

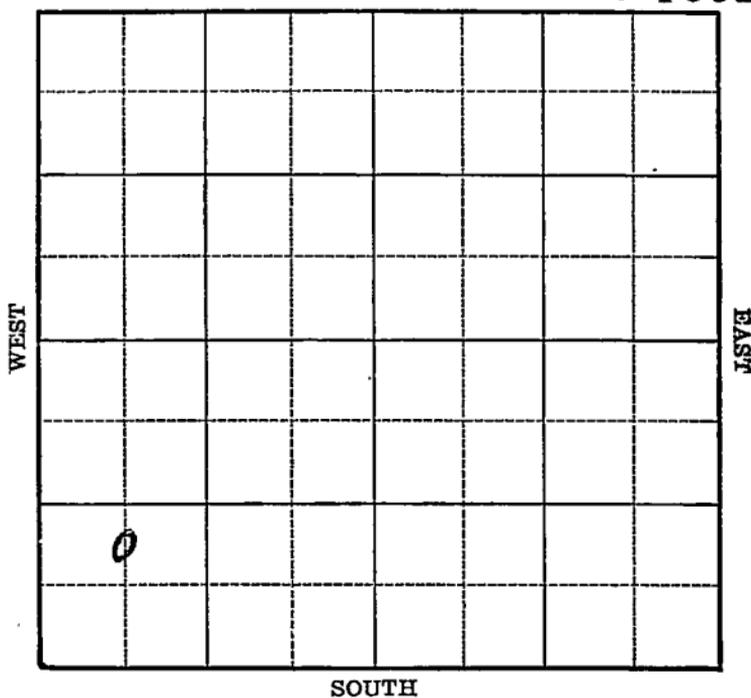

13

0

SOUTH





