

Section 12 Township 11 Range 18-W

Well No. #2 Hadley "A"

Company Darby


So. Burnett Pool

NORTH

WEST

EAST

SOUTH

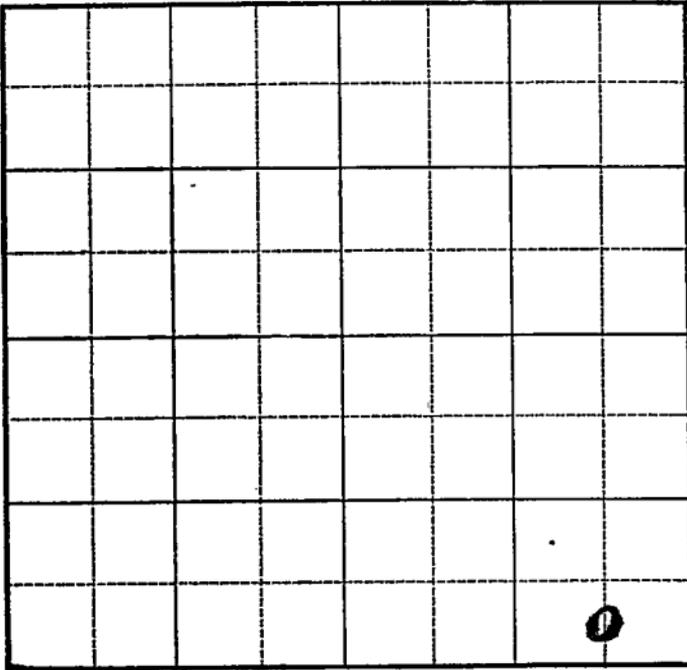

16

0

Map No. _____ Sec. 12 Twp. 11 R. 18W

Well No. 2 Hadley "A"

Darby

Company

Contractor

FIRST REPORT

C S $\frac{1}{2}$ SE SE

SECTION PLAT

			0

_____ Ft. from N. Line

330 Ft. from S. Line

660 Ft. from E. Line

_____ Ft. from W. Line

SOUTH BURNETT POOL

Location _____

RECORD

Cased _____ in., _____ ft.

Rig up _____

Sand _____

Drilling and Remarks:

Gas _____

ROG

Oil _____

Total Depth _____

PRODUCTION

1st 24 hrs. Nat. _____

1st 24 hrs. after shot _____

Gas _____ Cu. Ft.

Dry Hole _____

Abandoned _____

Date

JUN 21 1939

Map No. 71 Sec. 12 Twp. 11 R. 18W

Well No. 2 Hadley "A"

Darby

Company _____

Contractor _____

COMPLETED

SECTION PLAT

C S $\frac{1}{2}$ SE SE

_____ Ft. from N. Line

330 Ft. from S. Line

660 Ft. from E. Line

_____ Ft. from W. Line

			0

SOUTH BURNETT POOL

Location _____

Rig up _____

Drilling and Remarks:

Cr & 3332

7" @ 3332

2000 Acid

Depth graph

74.040

Maximum 3560

RECORD

Cased _____ in., _____ ft.

Sand _____

Gas _____

Oil _____

Total Depth 2335

PRODUCTION

1st 24 hrs. Nat. _____

1st 24 hrs. after shot _____

Gas _____ Cu. Ft.

Dry Hole _____

Abandoned _____

Date

JUL 26 1939 19

S. J. LEWIS

Scout