


Section 12 Township 11 Range 19 W

Well No. # 1 Gassaway

Company G-M-R Oil

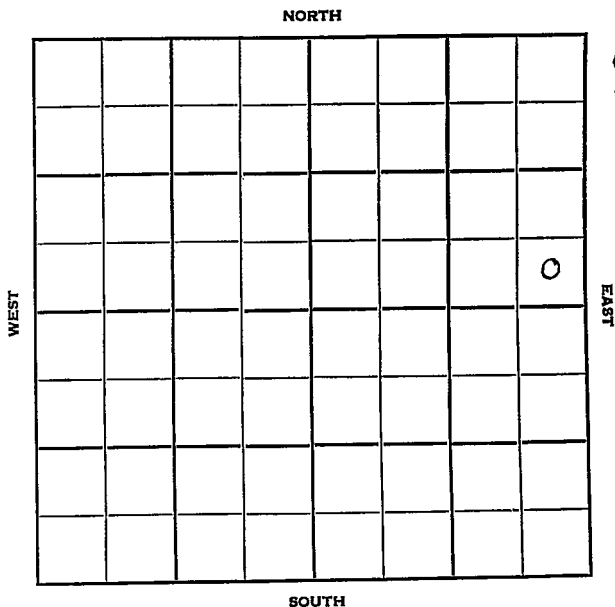

8

[Handwritten scribbles]

Ellis

KANSAS

Sec. 12 Twp. 11 R. 19 W

Well No. # 1 Gassaway Farm

G-M-R Oil Company

Fred Drlg. Contractor

Wildcat


 Ft. from N. Line

330 Ft. from S. Line

330 Ft. from E. Line

 Ft. from W. Line

SE SE NE

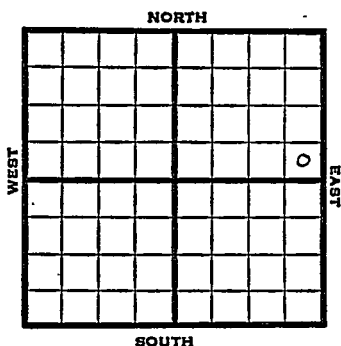

1951

Elev. 1997' REPORT

4/25

Location

5/23

Spud 4-24-51

D & A TD 3592' 8" @ 201'

Anhy 1330' Top 2993' Heeb 3212'

KC 3254'

DST 3420-30' open 1 hr. rec 32' OCM

B KC 3493' Cong 3514' Arb. 3587'

TD 3592' 5" @ 3590' S/ 5 BWPH

SP 3460' 24/3428-34 24/3417-23

24/3407-13 2000 A S/6 BO 1 hr.

Dec. to 1 BO 25 GWPH 2000 A water

D & A

ABANDONED

County Ellis State Kansas
 Sec. 12 (Blk.) 11 (Sur.) 19W Map No.

Operator G-M-R Oil

Well No. 1 Farm Gassaway

Elev. _____ Location SE SE NE

FIRST REPORT

330 Ft. From S Line NE

330 Ft. From E Line Quarter

1st. Report APR 25 1951

Completion _____

Remarks _____

Fred Drlg. - Contr.


Spudding Date _____

Drlg. Data _____

Wildcat

Location

J. E. TYRA

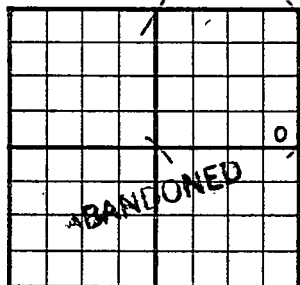County Ellis State KansasSec. 12 (Blk.
Twp.) 11 (Sur.
Rge.) 19W Map No.Operator G-M-R OilWell No. 1 Farm GassawayElev. 1997 Location SE SE NE330 Ft. From S Line NE330 Ft. From E Line Quarter

1st. Report

Completion MAY 23 1951Remarks WildcatFred Drlg. - Contr.Spudding Date 4-24-51Drlg. Data D & A TD 35928" @ 201 Anhy 1330 Top. 2993Heeb. 3212 KC 3254 DST 3420-30open 1 hr. Rec. 32' ocm B KC 3493Cong. 3514 Arb. 3587 TD 35925" @ 3590 S/ 5 bwph SP 346024/ 3428-34 24/ 3417-23 24/ 3407-132000 A S/ 6 bo 1 hr. Dec. to 1 bo25 gwph 2000 A waterD & A

J. E. TYRA