

# KANSAS

Ellis

Form 51-5M-7-39-Palace


7

Section 12 Township 11 Range 18-W

Well No. #3 Ridler "A"

Company Bay Petroleum

NORTH South Burnett Pool

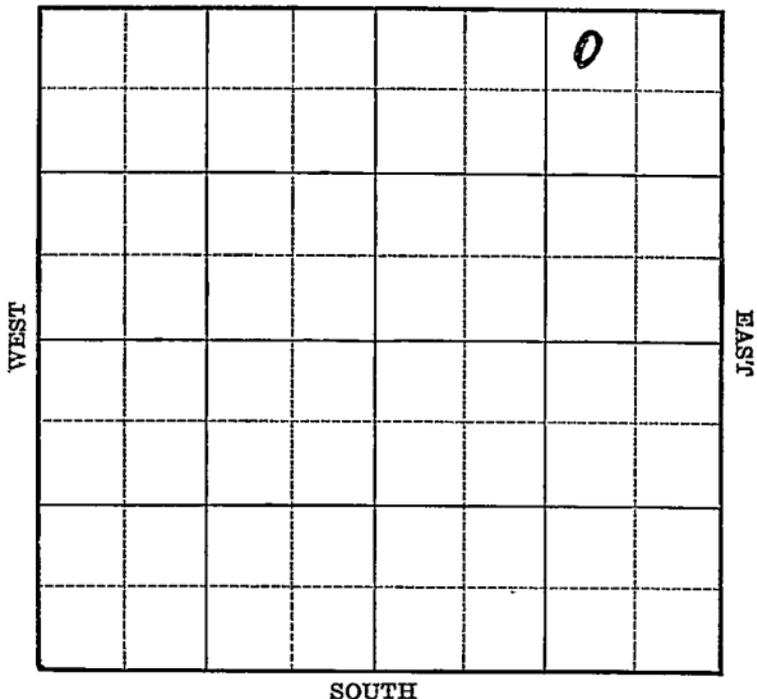

Sec. 12 Twp. 11 R. 18-W

Well No. #3 Ridler "A" Farm

Bay Petr. Company

(South Burnett)


330 Ft. from N. Line

\_\_\_\_\_ Ft. from S. Line

990 Ft. from E. Line

\_\_\_\_\_ Ft. from W. Line

Elev. 1928

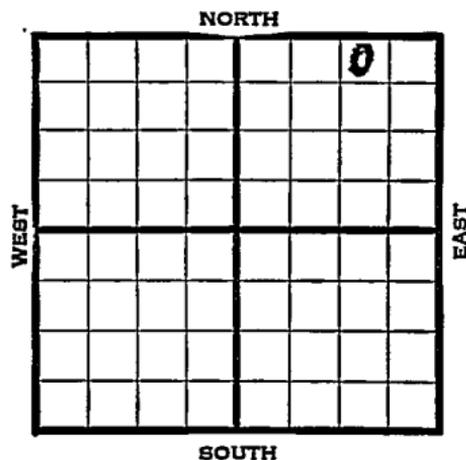

1940

REPORT

5/8 Anhy 1156'

8" - 1188'

Drlg. 1375'

5/16 Drlg. 2977'

5/23 Arb. 3446' T.D. 3450'

5" - 3446' RUST.

5/29 Arb. 3446'

5" - 3446'

T.D. 3452'

500 acid.

Echometer potential 15,032 bbls.

Maximum 3000 bbls.

COMPLETED

Map No. 71 Sec. 12 Twp. 11 R. 18WWell No. 3 Ridler "A"Bay Petroleum

Company

Contractor

**FIRST REPORT**

NW NE NE

330 Ft. from N. Line

\_\_\_\_\_ Ft. from S. Line

990 Ft. from E. Line

\_\_\_\_\_ Ft. from W. Line

SOUTH BURNETT POOL

**SECTION PLAT**

			o

Location \_\_\_\_\_

Rig up \_\_\_\_\_

Drilling and Remarks:

Anhy. 1156

8" - 1188

Dr1g. 1375

**RECORD**

Cased \_\_\_\_\_ in., \_\_\_\_\_ ft.

Sand \_\_\_\_\_

Gas \_\_\_\_\_

Oil \_\_\_\_\_

Total Depth \_\_\_\_\_

**PRODUCTION**

1st 24 hrs. Nat. \_\_\_\_\_

1st 24 hrs. after shot \_\_\_\_\_

Gas \_\_\_\_\_ Cu. Ft.

Dry Hole: \_\_\_\_\_

Abandoned \_\_\_\_\_

Date

MAY 8 1940 19S. J. LEWIS

Scout

