

KANSAS

Form 51-5M-7-40-Palace


Ellis

Section 12 Township 11 Range 18-W

Well No. #8 Kempe

Company Skelly Oil

NORTH Koblitz Pool

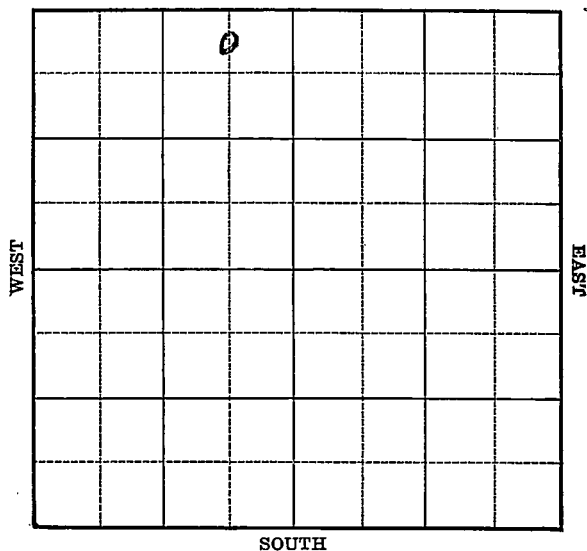

Sec. 12 Twp. 11 R. 18-WWell No. #8 Kempe FarmSkelly Oil

Company

(Koblitz)

330

Ft. from N. Line


Ft. from S. Line

660

Ft. from E. Line

Ft. from W. Line

Elev. 1903

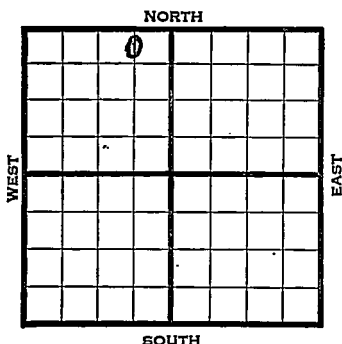

1940	REPORT
9/4	Drlg. 133'
9/12	16" - 106' 8" - 1179' WOC.
9/19	Drlg. 2800'
9/26	Drlg. 3369'
10/3	Lans. 3122' Cong. 3370'
	Simp. Dolo. 3380'
	Simp. shale 3395' Arb. 3397'
	T.D. 3453' 4" - 3451' RUST.
10/9	Arb. 3397'
	4 $\frac{1}{2}$ " - 3451'
	T.D. 3453'
	72 shots 3432-40'
	Echometer potential 62,017 bbls.
	Maximum 3000 bbls.
	COMPLETED

Map No. _____ Sec. 12 Twp. 11 R. 18WWell No. 8 KempeSkelly Oil

Company _____

Contractor _____

FIRST REPORT

C N L NE NW

330 Ft. from N. Line

_____ Ft. from S. Line

660 Ft. from E. Line

_____ Ft. from W. Line

KOBLITZ POOL**SECTION PLAT**

	o		

Location _____

Rig up _____

Drilling and Remarks:

Dr1g. 133**RECORD**

Cased _____ in., _____ ft.

Sand _____

Gas _____

Oil _____

Total Depth _____

PRODUCTION

1st 24 hrs. Nat. _____

1st 24 hrs. after shot _____

Gas _____ Cu. Ft.

Dry Hole _____

Abandoned _____

Date

SEP 4 194019S. J. LEWIS

Scout

Map No. 71 Sec. 12 Twp. 11 R. 18WWell No. 8 KempeSkelly Oil

Company

Contractor

COMPLETED

C N L NE NW

330 Ft. from N. Line Ft. from S. Line660 Ft. from E. Line Ft. from W. Line

KOBELITZ POOL

SECTION PLAT

Location Rig up

Drilling and Remarks:

*CEL 3397**4 1/2" @ 3451**72 Shots 3432-40**Echo P 8.62017**Max 3000***RECORD**Cased in., ft.Sand Gas Oil Total Depth 3453**PRODUCTION**1st 24 hrs. Nat. 1st 24 hrs. after shot Gas Cu. Ft.Dry Hole Abandoned

Date

OCT 9 1940 19 S. J. LEWIS Scout