

KANSAS


Ellis

Form 51-5M-7-39-Palace

Section 12 Township 11 Range 18W

Well No. #2 Riddler "A"

Company Shell

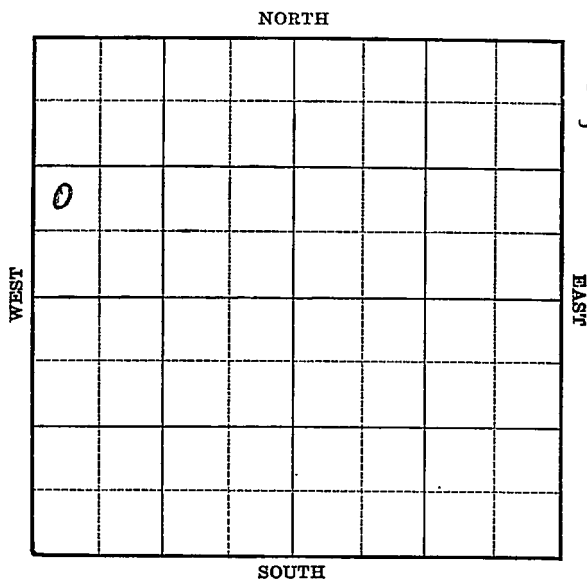

KANSAS

Ellis

Sec. 12 Twp. 11 R. 18-WWell No. #2 Riddler "A" FarmShell

Company

(Burnett)


 Ft. from N. Line992

Ft. from S. Line

 Ft. from E. Line330

Ft. from W. Line

Elev. 1936

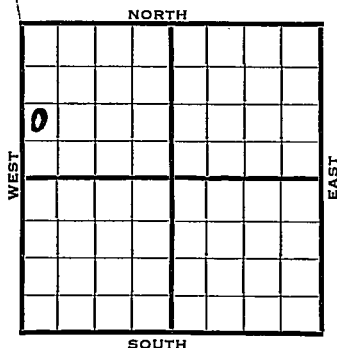

	REPORT
1940	
7/2	Cellar.
7/11	13" - 158' 8" - 1189'
	Drlg. 1267'
7/18	Drlg. 2916'
7/25	Topeka 2883' Ians. 3176'
	Cong. 3396' Arb. 3433'
	Drlg. 3507'
8/2	4" - 3507' Top plug 3481'
	47 shots 3425-70'
	2950' 1½ hours. Testing.
8/7	Arb. 3433'
	4" - 3507'
	T.D. 3507'
	47 shots 3470-75'
	Depthograph potential 9510 bbls.
	Maximum 3000 bbls.
	COMPLETED

Map No. 7/ Sec. 12 Twp. 11 R. 18WWell No. 2 Riddler "A"Shell

Company

Contractor

FIRST REPORT

NW SW NW

 Ft. from N. Line992 Ft. from S. Line Ft. from E. Line330 Ft. from W. Line

BURNETT POOL

SECTION PLAT

o			

Location Rig up

Drilling and Remarks:

Cellar

RECORD

Cased in., ft.Sand Gas Oil Total Depth

PRODUCTION

1st 24 hrs. Nat. 1st 24 hrs. after shot Gas Cu. Ft.Dry Hole Abandoned

Date

JUL 2 194019S. J. LEWIS Scout

Map No. 71 Sec. 12 Twp. 11 R. 18WWell No. 2 Riddler "A"Shell

Company

Contractor

COMPLETED**SECTION PLAT**

NW SW NW

 Ft. from N. Line992 Ft. from S. Line Ft. from E. Line330 Ft. from W. Line

BURNETT POOL

0			

Location Rig up

Drilling and Remarks:

*CR 83433**4 " @ 3507**47 Sk + to 3470-75**Depth graph 28**9510**May 3000***RECORD**Cased in., ft.Sand Gas Oil Total Depth 2507**PRODUCTION**1st 24 hrs. Nat. 1st 24 hrs. after shot Gas Cu. Ft.Dry Hole Abandoned

Date

AUG 7 1940 19

S. J. LEWIS Scout