

Section 12 Township 11 Range 20W

Well No. #1 Warren

Company Atlas Drlg.

NORTH

WEST

EAST

SOUTH

5

0



Sec. 12 Twp. 11 R. 20 W

Well No. # 1 Warren Farm

Atlas Drlg. Company


Atlas Contractor
Wildcat

Ft. from N. Line

330 Ft. from S. Line

Ft. from E. Line

330 Ft. from W. Line

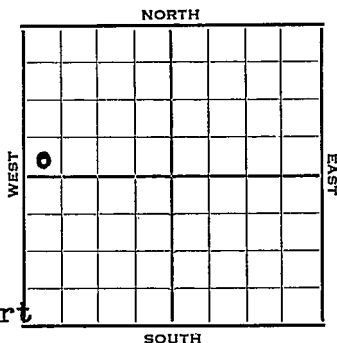

SW SW NW

Sinclair Farmout & Support

1952 Elev. 2028' REPORT

9/24

Spud 9-16-52
8" @ 226

10/1

Drlg. 2805'
Spud 9-16-52
D & A TD 3520' 8" @ 226
Heeb 3299' Lans. 3341'
TD 3520' D & A

ABANDONED

County Ellis State Kansas

Sec. 12 (Blk. Twp.) 11 (Sur. Rge.) 20W Map No.

Operator Atlas Drlg.

Well No. 1 Farm Warren

Elev. 2028 Location SW SW NW

0					

330 Ft. From S Line NW

330 Ft. From W Line Quarter

Ist. Report

Completion OCT 1 1952

Remarks Wildcat

Atlas - Contr.

Spudding Date 9-16-52

Drlg. Data D & A TD 3520

8" @ 226 Heeb. 3299 Lans. 3341

TD 3520

D & A